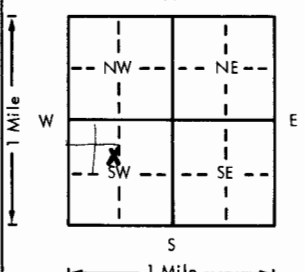


USE TYPEWRITER OR BALL  
POINT PEN-PRESS FIRMLY,  
PRINT CLEARLY.

WATER WELL RECORD  
KSA 82a-1201-1215

Kansas Department of Health and  
Environment-Division of Environment  
(Water well Contractors)  
Topeka, Kansas 66620

X Location of well:		County <b>McPherson</b>	Fraction <b>1/4 NW 1/4 SW 1/4</b>	Section number <b>29</b>	Township number <b>21</b>	Range number <b>2</b>	E/W <b>E</b>
2. Distance and direction from nearest town or city: Street address of well location if in city:		3. Owner of well: R.R. or street: City, state, zip code:		Gayland Flickner Moundridge, Kansas			
4. Locate with "X" in section below:		Sketch map:		6. Bore hole dia. <b>30</b> in. Completion date <b>7-20-77</b> Well depth <b>141</b> ft.			
				7. Cable tool <input type="checkbox"/> Rotary <input type="checkbox"/> Driven <input type="checkbox"/> Dug <input checked="" type="checkbox"/> Hollow rod <input type="checkbox"/> Jetted <input type="checkbox"/> Bored <input checked="" type="checkbox"/> Reverse rotary			
5. Type and color of material		From To		8. Use: Domestic <input type="checkbox"/> Public supply <input type="checkbox"/> Industry <input checked="" type="checkbox"/> Irrigation <input type="checkbox"/> Air conditioning <input type="checkbox"/> Stock <input type="checkbox"/> Lawn <input type="checkbox"/> Oil field water <input type="checkbox"/> Other <input type="checkbox"/>			
Topsoil		0 2		9. Casing: Material <b>Transite</b> Height: Above or below <b>141</b> in. Threaded <input type="checkbox"/> Welded <input type="checkbox"/> Surface <input type="checkbox"/> RMP <input type="checkbox"/> PVC <input type="checkbox"/> Weight <b>37</b> lbs./ft. Dia. <b>16</b> in. to <b>141</b> ft. depth Wall Thickness: inches or <b>3/4</b> in. to <b>141</b> ft. depth gage No. <b>3/4</b> in.			
Clay		2 6		10. Screen: Manufacturer's name <b>Transite, Johnson</b> Type <b>Irrigator</b> Dia. <b>16</b> in. Slot/gauge <b>.100</b> Length <b>13</b> ft. 20 in. Set between <b>119</b> ft. and <b>139</b> ft. Gravel pack? <b>yes</b> Size range of material <b>4-1/8</b> in.			
Sandy Clay		6 15		11. Static water level: <b>30</b> ft. below land surface Date <b>7-20-77</b>			
Clay		15 46		12. Pumping level below land surfaces: ft. after hrs. pumping g.p.m. ft. after hrs. pumping g.p.m. Estimated maximum yield g.p.m.			
Fine Sand		46 50		13. Water sample submitted: mo./day/yr. Yes No Date			
Clay		50 70		14. Well head completion: <b>24</b> capped Pitless adapter inches above grade			
Fine to coarse sand and gravel		70 74		15. Well grouted? <b>yes 1-2 fine sand mix</b> With: Neat cement Bentonite <input checked="" type="checkbox"/> Concrete Depth: From <b>0</b> ft. to <b>10</b> ft.			
Clay		74 84		16. Nearest source of possible contamination: <b>NONE</b> ft. Direction Type Well disinfected upon completion? <input checked="" type="checkbox"/> Yes No			
Fine to coarse sand and gravel		84 96		17. Pump: <input checked="" type="checkbox"/> Not installed Manufacturer's name Model number HP Volts Length of drop pipe ft. capacity g.p.m. Type: Submersible Turbine Jet Reciprocating Centrifugal Other			
Clay		96 103		20. Water well contractor's certification: This well was drilled under my jurisdiction and this report is true to the best of my knowledge and belief. <b>Harp Well &amp; Pump 236</b> Business name <b>Wichita, Kansas</b> License No. Address Signature <b>M. Arnold</b> Date <b>8-31-77</b> Authorized representative			
Fine to coarse sand and gravel		103 140					
Red Shale		140 141					
(Use a second sheet if needed)							
18. Elevation:		19. Remarks:					
Topography: Hill Slope Upland Valley		<b>From #9 Banded But Joint</b> <b>No apparent source for contamination.</b>					

Forward the white, blue and pink copies to the Department of Health and Environment

Form WWC-5