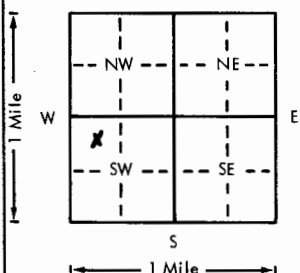


USE TYPEWRITER OR BALL
POINT PEN-PRESS FIRMLY,
PRINT CLEARLY.

WATER WELL RECORD
KSA 82a-1201-1215

Kansas Department of Health and
Environment-Division of Environment
(Water well Contractors)
Topeka, Kansas 66620

1. Location of well:		County McPherson	Fraction C 1/4 NW 1/4 SW 1/4	Section number 31	Township number 21	Range number 2W	E/W
2. Distance and direction from nearest town or city: 4 West of Moundridge Street address of well location if in city: Kansas, 1 3/4 South				3. Owner of well: Dale Jantzen R.R. or street: Moundridge, Kansas City, state, zip code:			
4. Locate with "X" in section below:		Sketch map:		6. Bore hole dia. 30 in. Completion date Well depth 110 ft. 5-10-77			
				7. <input type="checkbox"/> Cable tool <input type="checkbox"/> Rotary <input type="checkbox"/> Driven <input type="checkbox"/> Dug <input type="checkbox"/> Hollow rod <input type="checkbox"/> Jetted <input type="checkbox"/> Bored <input checked="" type="checkbox"/> Reverse rotary			
5. Type and color of material		From		To		8. Use: <input checked="" type="checkbox"/> Domestic <input type="checkbox"/> Public supply <input type="checkbox"/> Industry <input checked="" type="checkbox"/> Irrigation <input type="checkbox"/> Air conditioning <input type="checkbox"/> Stock <input type="checkbox"/> Lawn <input type="checkbox"/> Oil field water <input type="checkbox"/> Other	
Clay		0		20		9. Casing: Material Transite Height: Above or below Threaded <input type="checkbox"/> Welded <input type="checkbox"/> Surface 12 in. RMP 16 PVC 110 Weight 37 lbs./ft. Dia. 16 in. to 110 ft. depth Wall Thickness 3/4 in. or Dia. 16 in. to 110 ft. depth gage No. 3/4	
Fine Sand		20		32		10. Screen: Manufacturer's name Johnson Type irrigator Dia. 16 in. Slot/gauge 100 Length 25 ft. Set between 85 ft. and 110 ft. ft. and 110 ft. Gravel pack? yes size range of material 4-1/8"	
Clay		32		60		11. Static water level: 31 ft. below land surface Date 5-10-77	
Fine to coarse Sand and medium gravel						12. Pumping level below land surfaces: ft. after hrs. pumping g.p.m. ft. after hrs. pumping g.p.m. Estimated maximum yield g.p.m.	
with some clay		60		110		13. Water sample submitted: mo./day/yr. Yes No Date	
						14. Well head completion: 12 capped Pitless adapter 12 inches above grade	
						15. Well grouted? yes 1-2 fine sand mix With: <input type="checkbox"/> Neat cement <input checked="" type="checkbox"/> Bentonite <input type="checkbox"/> Concrete Depth: From 0 ft. to 10 ft.	
						16. Nearest source of possible contamination: NONE ft. Direction Type Well disinfected upon completion? <input checked="" type="checkbox"/> Yes <input type="checkbox"/> No	
						17. Pump: <input checked="" type="checkbox"/> Not installed Manufacturer's name Model number HP Volts Length of drop pipe ft. capacity g.p.m. Type: <input type="checkbox"/> Submersible <input type="checkbox"/> Turbine <input type="checkbox"/> Jet <input type="checkbox"/> Reciprocating <input type="checkbox"/> Centrifugal <input type="checkbox"/> Other	
18. Elevation:		19. Remarks:		20. Water well contractor's certification: This well was drilled under my jurisdiction and this report is true to the best of my knowledge and belief. Harp Well & Pump 236 Business name Wichita, Kansas License No. Address Signed M. Arnold Date 8-5-77 Authorized representative			
Topography: <input type="checkbox"/> Hill <input type="checkbox"/> Slope <input type="checkbox"/> Upland <input type="checkbox"/> Valley		Flat Ground From #9 Banded But Joint No near apparent source for contamination.					

Forward the white, blue and pink copies to the Department of Health and Environment

Form WWC-5