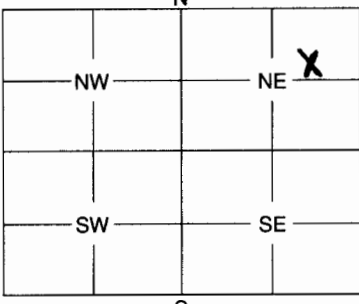


## WATER WELL PLUGGING RECORD Form WWC-5P KSA 82a-1212 ID NO. \_\_\_\_\_

1	LOCATION OF WATER WELL:	Fraction	Section	Number	Township	Number	Range	Number																							
	County: <b>McPherson</b>	<b>SW 1/4 NE 1/4 NE 1/4</b>		<b>22</b>		<b>21</b>	<b>2</b>																								
Distance and direction from nearest town or city street address of well if located within city? <b>City Limits- 305 Unruh, Moundridge, Ks</b>																															
2	WATER WELL OWNER: <b>Del Hueske</b> RR #, St. Address, Box #: <b>305 Unruh</b> City, State, ZIP Code : <b>Moundridge, Ks. 67107</b> Board of Agriculture, Division of Water Resources Application Number:																														
3	MARK WELL'S LOCATION WITH AN "X" IN SECTION BOX:		4 DEPTH OF WELL <b>3 @ 200</b> ft. WELL'S STATIC WATER LEVEL <b>22</b> ft. WELL WAS USED AS: 1 Domestic 5 Public Water Supply 9 Dewatering 2 Irrigation 6 Oil Field Water Supply 10 Monitoring Well 3 Feedlot 7 Domestic (Lawn & Garden) 11 Injection Well 4 Industrial 8 Air Conditioning <b>1X Other Geothermal</b> Was a chemical / bacteriological sample submitted to Department? Yes No <b>X</b> If yes, mo/day/yr sample was submitted Water Well Disinfected: Yes <b>X</b> No																												
																															
5	TYPE OF BLANK CASING USED: 1 Steel 3 RMP (SR) 5 Wrought 7 Fiberglass <b>9 Other (Specify below)</b> 2 PVC 4 ABS 6 Asbestos-Cement 8 Concrete Tile <b>Polyethylene</b> Blank casing diameter <b>3/4</b> in. Was casing pulled? Yes No If yes, how much Casing height above or below land surface in.																														
6	GROUT PLUG MATERIAL: 1 Neat cement 2 Cement grout <b>3 Bentonite</b> 4 Other Grout Plug Intervals: From <b>0</b> ft. to <b>200</b> ft., From <b>0</b> ft. to <b>200</b> ft., From <b>0</b> to <b>200</b> ft. What is the nearest source of possible contamination: 1 Septic tank 6 Seepage pit 11 Fuel storage 16 Other (specify below) 2 Sewer lines 7 Pit privy 12 Fertilizer storage <b>X Watertight sewer lines</b> 8 Sewage lagoon 13 Insecticide storage 4 Lateral lines 9 Feedyard 14 Abandoned water well 5 Cess pool 10 Livestock pens 15 Oil well/Gas well Direction from well? <b>North</b> How many feet? <b>50'</b>																														
<table border="1"><thead><tr><th>FROM</th><th>TO</th><th>LOG</th></tr></thead><tbody><tr><td>0</td><td>2</td><td>Topsoil</td></tr><tr><td>2</td><td>12</td><td>Clay, gray</td></tr><tr><td>12</td><td>26</td><td>Clay, gray w/small sand layers</td></tr><tr><td>26</td><td>66</td><td>Shale, gray</td></tr><tr><td>66</td><td>84</td><td>Shale, red</td></tr><tr><td>84</td><td>104</td><td>Shale, gray</td></tr><tr><td>104</td><td>132</td><td>Shale, green</td></tr>
7	CONTRACTOR'S OF LANDOWNER'S CERTIFICATION: This water well was plugged under my jurisdiction and was completed on (mo/day/year) <b>12/10/08</b> and this record is true to the best of my knowledge and belief. Kansas Water Well Contractor's License No. <b>138</b> This Water Well Record was completed on (mo/day/year) <b>12/31/08</b> under the business name of <b>Peterson Irrigation, Inc.</b> by (signature) <i>Mike Peterson</i>																														
INSTRUCTIONS: Use typewriter or ball point pen. Please press firmly and print clearly. Please fill in blanks, underline or circle the correct answers. Send top three copies to Kansas Department of Health and Environment, Bureau of Water, Geology Section, 1000 SW Jackson St., Ste. 420, Topeka, Kansas 66612-1367. Telephone: 785/296-5522. Send one to Water Well Owner and retain one for your records.																															

1	LOCATION OF WATER WELL:	Fraction	Section Number	Township Number	Range Number
County: <b>McPherson</b>	<b>SW <math>\frac{1}{4}</math> NE <math>\frac{1}{4}</math> NE <math>\frac{1}{4}</math></b>	<b>22</b>	<b>21</b>	<b>2</b>	<b>EW</b>

Distance and direction from nearest town or city street address of well if located within city?

**City limits-- 1147 N. Maxwell, McPherson, Ks.**

2	WATER WELL OWNER: <b>Del Hueske</b>	
	RR #, St. Address, Box #: <b>1147 N. Maxwell</b>	Board of Agriculture, Division of Water Resources
	City, State, ZIP Code: <b>McPherson, Ks. 67460</b>	Application Number:

3	MARK WELL'S LOCATION WITH AN "X" IN SECTION BOX:	4	DEPTH OF WELL ..... <b>3</b> ..... <b>200</b> ..... ft.
			WELL'S STATIC WATER LEVEL ..... <b>22</b> ..... ft.
			WELL WAS USED AS:
			1 Domestic      5 Public Water Supply      9 Dewatering 2 Irrigation    6 Oil Field Water Supply    10 Monitoring Well 3 Feedlot       7 Domestic (Lawn & Garden)   11 Injection Well 4 Industrial    8 Air Conditioning <input checked="" type="checkbox"/> Other <b>Geothermal</b> .....
			Was a chemical / bacteriological sample submitted to Department? Yes ..... No <b>X</b> .....
			If yes, mo/day/yr sample was submitted .....
			Water Well Disinfected: Yes <b>X</b> .. No .....

5	TYPE OF BLANK CASING USED:	
	1 Steel      3 RMP (SR)      5 Wrought      7 Fiberglass <input checked="" type="checkbox"/> Other (Specify below) 2 PVC      4 ABS      6 Asbestos-Cement      8 Concrete Tile <b>Polyethylene</b> .....	
	Blank casing diameter ..... <b>3/4</b> ..... in.	Was casing pulled? Yes ..... No ..... If yes, how much .....
	Casing height above or below land surface ..... in.	

6	GROUT PLUG MATERIAL:	1 Neat cement	2 Cement grout	<input checked="" type="checkbox"/> Bentonite	4 Other .....
	Grout Plug Intervals:	From ..... <b>0</b> ..... ft.	to ..... <b>200</b> ..... ft.	From ..... <b>0</b> ..... ft.	to ..... <b>200</b> ..... ft.
	What is the nearest source of possible contamination:				
	1 Septic tank      6 Seepage pit      11 Fuel storage      16 Other (specify below) 2 Sewer lines      7 Pit privy      12 Fertilizer storage <input checked="" type="checkbox"/> Watertight sewer lines      8 Sewage lagoon      13 Insecticide storage 4 Lateral lines      9 Feedyard      14 Abandoned water well 5 Cess pool      10 Livestock pens      15 Oil well/Gas well				
	Direction from well? <b>North</b> .....	How many feet? <b>50 ft.</b> .....			

FROM	TO	LOG <del>X</del> <b>XXXXXXXXXXXX</b>
<b>0</b>	<b>2</b>	<b>Topsoil</b>
<b>2</b>	<b>12</b>	<b>Clay, gray</b>
<b>12</b>	<b>26</b>	<b>Clay, gray w/small sand layers</b>
<b>26</b>	<b>66</b>	<b>Shale, gray</b>
<b>66</b>	<b>84</b>	<b>Shale, red</b>
<b>84</b>	<b>104</b>	<b>Shale, gray</b>
<b>104</b>	<b>132</b>	<b>Shale, green</b>

LOG

**132 to 200 Shale, gray**

7	CONTRACTOR'S OF LANDOWNER'S CERTIFICATION: This water well was plugged under my jurisdiction and was completed on (mo/day/year) ..... <b>12/10/08</b> ..... and this record is true to the best of my knowledge and belief. Kansas	
	Water Well Contractor's License No. <b>138</b>	This Water Well Record was completed on (mo/day/year) <b>12/17/08</b>
	by (signature) <i>M. Peterson</i> under the business name of <b>Peterson Irrigation, Inc.</b>	

INSTRUCTIONS: Use typewriter or ball point pen. Please press firmly and print clearly. Please fill in blanks, underline or circle the correct answers. Send top three copies to Kansas Department of Health and Environment, Bureau of Water, Geology Section, 1000 SW Jackson St., Ste. 420, Topeka, Kansas 66612-1367. Telephone: 785/296-5522. Send one to Water Well Owner and retain one for your records.