

WATER WELL PLUGGING RECORD Form WWC-5P

KSA 82a-1212

ID NO.

6221

1 LOCATION OF WATER WELL: Fraction NW ¼ NW ¼ SW ¼ SE ¼ Section Number 32 Township Number T 21 S Range Number 2 ☐ E ☒ W
County: McPherson

Street/Rural Address of Well Location; if unknown, distance & direction from nearest town or intersection: If at owner's address, check here ☐ From Moundridge 2S 2 1/2W NSR

Global Positioning Systems (GPS) information:

Latitude: 38.17758 (in decimal degrees)

Longitude: 097.56466 (in decimal degrees)

Elevation:


Datum: ☐ WGS84, ☐ NAD83, ☒ NAD27

Collection Method:

☐ GPS unit (Make/Model: garmin)☐ Digital Map/Photo, ☒ Topographic Map, ☐ Land SurveyEst. Accuracy: ☐ < 3 m, ☒ 3-5 m, ☐ 5-15 m, ☐ > 15 m

2 WATER WELL OWNER: Kirby Jantzen
RR#, St. Address, Box #: 43-19th Ave.
City, State ZIP Code: Moundridge, Kansas 67107

3 MARK WELL'S LOCATION WITH AN "X" IN SECTION BOX:

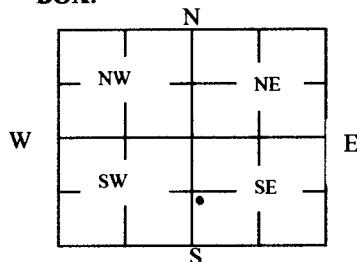

4 DEPTH OF WELL 137 ft.

WELL'S STATIC WATER LEVEL 52 ft

WELL WAS USED AS:

☐ Domestic
☒ Irrigation
☐ Feedlot
☐ Industrial

☐ Public Water Supply
☐ Oil Field Water Supply
☐ Domestic (Lawn & Garden)
☐ Air Conditioning

☐ Dewatering
☐ Monitoring
☐ Injection Well
☐ Other

Was a chemical/bacteriological sample submitted to Department? Yes ☐ No ☒

5 TYPE OF BLANK CASING USED:

☒ Steel
☐ PVC

☐ RMP (SR)
☐ ABS

☐ Wrought
☐ Asbestos-Cement

☐ Fiberglass
☐ Concrete Tile

☐ Other (Specify below)

Blank casing diameter 18 in. Was casing pulled? Yes ☐ No ☒ If yes, how much _____
Casing height above or below land surface 40 in.

6 GROUT PLUG MATERIAL: ☐ Neat cement ☐ Cement grout ☐ Bentonite ☒ Other Hole plug

Grout Plug Intervals: From 0 ft. to 3 ft., From 3 ft. to 45 ft., From 45 to 137 ft.

What is the nearest source of possible contamination:

☐ Septic tank
☐ Sewer lines
☐ Watertight sewer lines
☐ Lateral lines
☐ Cess pool

☐ Seepage pit
☐ Pit privy
☐ Sewage lagoon
☐ Feedyard
☐ Livestock pens

☐ Fuel Storage
☐ Fertilizer storage
☐ Insecticide storage
☐ Abandoned water well
☐ Oil well/Gas well

☒ Other (specify below)
Pond

Direction from well? North

How many feet? 55'

FROM	TO	PLUGGING MATERIALS	FROM	TO	PLUGGING MATERIALS
0	3	Dirt			
3	45	Hole plug			
45	137	Sand			

7 CONTRACTOR'S OR LANDOWNER'S CERTIFICATION: This water well was plugged under my jurisdiction and was completed on (mo/day/year) 3-16-2012 and this record is true to the best of my knowledge and belief. Kansas Water Well Contractor's License No. 134. This Water Well Record was completed on (mo/day/year) 3-29-2012 under the business name of Rosencrantz-Bemis Enterprise by (signature) *Daniel A. Dodson*

INSTRUCTIONS: Use typewriter or ballpoint pen. Please press firmly and print clearly. Please fill in blanks, underline or circle the correct answers. Send top three copies to Kansas Department of Health and Environment, Bureau of Water, Geology Section, 1000 SW Jackson St., Ste. 420, Topeka, Kansas 66612-1367. Telephone: 785/296-5524. Send one to Water Well Owner and retain one for your records. Visit us at <http://www.kdheks.gov/waterwell/index.html>.

Check one: ☒ White Copy ☐ Blue Copy ☐ Pink Copy