

## WATER WELL PLUGGING RECORD Form WWC-5P

KSA 82a-1212

ID NO.

36870, 41884, &amp; 45195

<b>1 LOCATION OF WATER WELL:</b> County: McPherson	Fraction ¼ SW ¼ SW ¼ NW ¼	Section Number 27	Township Number T 21 S	Range Number 2 <input type="checkbox"/> E <input checked="" type="checkbox"/> W
---	------------------------------	----------------------	---------------------------	--

Street/Rural Address of Well Location; if unknown, distance & direction from nearest town or intersection: If at owner's address, check here ☐ Approximately 0.75 miles west of

Moundridge, KS

**Global Positioning Systems (GPS) information:**

Latitude: 38.19727 (in decimal degrees)

Longitude: -97.53489 (in decimal degrees)

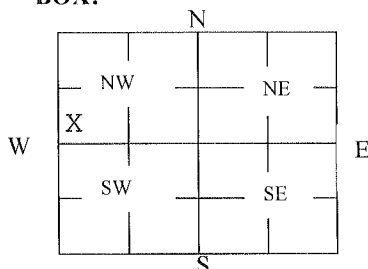
Elevation:

Datum: ☐ WGS84, ☐ NAD83, ☒ NAD27

Collection Method:

☒ GPS unit (Make/Model: Garmin GPSmap 60CSx☐ Digital Map/Photo, ☐ Topographic Map, ☐ Land SurveyEst. Accuracy: ☐ < 3 m, ☒ 3-5 m, ☐ 5-15 m, ☐ > 15 m

**2 WATER WELL OWNER:** Homer D. Goering Trust  
RR#, St. Address, Box #: 190 21st Avenue  
City, State ZIP Code: Moundridge, KS 67107

**3 MARK WELL'S LOCATION WITH AN "X" IN SECTION BOX:****4 DEPTH OF WELL** 47 ft. SE well of battery

WELL'S STATIC WATER LEVEL 13 ft

WELL WAS USED AS:

☐ Domestic  
☒ Irrigation  
☐ Feedlot  
☐ Industrial

☐ Public Water Supply  
☐ Oil Field Water Supply  
☐ Domestic (Lawn & Garden)  
☐ Air Conditioning

☐ Dewatering  
☐ Monitoring  
☐ Injection Well  
☐ Other
Was a chemical/bacteriological sample submitted to Department? Yes ☐ No ☒**5 TYPE OF BLANK CASING USED:**
☐ Steel  
☒ PVC

☐ RMP (SR)  
☐ ABS

☐ Wrought  
☐ Asbestos-Cement

☐ Fiberglass  
☐ Concrete Tile
☐ Other (Specify below)

Blank casing diameter 6 in. Was casing pulled? Yes ☒ No ☒ If yes, how much \_\_\_\_\_  
 Casing height above or below land surface below 36 in.

**6 GROUT PLUG MATERIAL:** ☐ Neat cement ☐ Cement grout ☒ Bentonite ☐ Other

Grout Plug Intervals: From 13 ft. to 3 ft., From \_\_\_\_\_ ft. to \_\_\_\_\_ ft., From \_\_\_\_\_ to \_\_\_\_\_ ft.

What is the nearest source of possible contamination:

☐ Septic tank  
☐ Sewer lines  
☐ Watertight sewer lines  
☐ Lateral lines  
☐ Cess pool

☐ Seepage pit  
☐ Pit privy  
☐ Sewage lagoon  
☐ Feedyard  
☒ Livestock pens

☐ Fuel Storage  
☐ Fertilizer storage  
☐ Insecticide storage  
☐ Abandoned water well  
☐ Oil well/Gas well
☐ Other (specify below)

Direction from well? Northwest

How many feet? approx. 890 ft.

FROM	TO	PLUGGING MATERIALS	FROM	TO	PLUGGING MATERIALS
47	13	Clean, coarse sand			
13	3	Bentonite Hole-Plug			
3	0	Topsoil			
					Well plugging witnessed by
					D. Randolph, GMD2 staff, on 4-2-13.

**7 CONTRACTOR'S OR LANDOWNER'S CERTIFICATION:** This water well was plugged under my jurisdiction and was completed on (mo/day/year) 4-2-2013 and this record is true to the best of my knowledge and belief. Kansas Water Well Contractor's License No. \_\_\_\_\_. This Water Well Record was completed on (mo/day/year) 4-2-2013 under the business name of Homer D. Goering Trust by (signature) [Signature]

**INSTRUCTIONS:** Use typewriter or ballpoint pen. Please press firmly and print clearly. Please fill in blanks, underline or circle the correct answers. Send top three copies to Kansas Department of Health and Environment, Bureau of Water, Geology Section, 1000 SW Jackson St.

APR 10 2013

☐ White Copy ☐ Blue Copy ☐ Pink Copy