

WATER WELL PLUGGING RECORD Form WWC-5P

KSA 82a-1212

ID NO.

31280

1 LOCATION OF WATER WELL: County: Harvey	Fraction ¼ NW ¼ SE ¼ NW ¼	Section Number 4	Township Number T 22 S	Range Number 3 <input type="checkbox"/> E <input checked="" type="checkbox"/> W
--	------------------------------	---------------------	---------------------------	--

Street/Rural Address of Well Location; if unknown, distance & direction from nearest town or intersection: If at owner's address, check here ☐ Approximately 5.75 miles east and

1.75 miles north of Buhler, KS

Global Positioning Systems (GPS) information:

Latitude: 38.16969 (in decimal degrees)

Longitude: -97.66023 (in decimal degrees)

Elevation:

Datum: ☐ WGS84, ☐ NAD83, ☒ NAD27

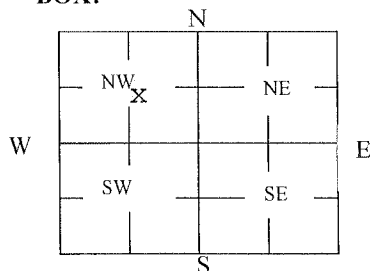
Collection Method:

☒ GPS unit (Make/Model: Garmin GPSmap 60CSx)

☐ Digital Map/Photo, ☐ Topographic Map, ☐ Land Survey

Est. Accuracy: ☐ < 3 m, ☒ 3-5 m, ☐ 5-15 m, ☐ > 15 m

2 WATER WELL OWNER: Orvin Voth
RR#, St. Address, Box #: 303 W. Broadway
City, State ZIP Code: Newton, KS 67114

3 MARK WELL'S LOCATION WITH AN "X" IN SECTION BOX:**4 DEPTH OF WELL** 180 **ft.**

WELL'S STATIC WATER LEVEL 50.1 **ft**

WELL WAS USED AS:

☐ Domestic
☒ Irrigation
☐ Feedlot
☐ Industrial

☐ Public Water Supply
☐ Oil Field Water Supply
☐ Domestic (Lawn & Garden)
☐ Air Conditioning

☐ Dewatering
☐ Monitoring
☐ Injection Well
☐ Other

Was a chemical/bacteriological sample submitted to Department? Yes ☐ No ☒

5 TYPE OF BLANK CASING USED:

☒ Steel
☐ PVC

☐ RMP (SR)
☐ ABS

☐ Wrought
☐ Asbestos-Cement

☐ Fiberglass
☐ Concrete Tile

☐ Other (Specify below)

Blank casing diameter 16 in. Was casing pulled? Yes ☐ No ☒ If yes, how much _____
Casing height above or below land surface below 72 in.

6 GROUT PLUG MATERIAL: ☐ Neat cement ☒ Cement grout ☐ Bentonite ☐ Other

Grout Plug Intervals: From 50.1 ft. to 6 ft., From _____ ft. to _____ ft., From _____ to _____ ft.

What is the nearest source of possible contamination:

☐ Septic tank
☐ Sewer lines
☐ Watertight sewer lines
☐ Lateral lines
☐ Cess pool

☐ Seepage pit
☐ Pit privy
☐ Sewage lagoon
☐ Feedyard
☐ Livestock pens

☒ Fuel Storage
☐ Fertilizer storage
☐ Insecticide storage
☐ Abandoned water well
☐ Oil well/Gas well

☐ Other (specify below)

Direction from well? West

How many feet? 20 feet

FROM	TO	PLUGGING MATERIALS	FROM	TO	PLUGGING MATERIALS
180	166	Formation sand (casing collapsed)			Well plugging witnessed by
166	50.1	Clean, coarse sand			D. Randolph, GMD2 staff, on
50.1	6	Cement grout			5/6/2013 and 5/7/2013
6	0	Topsoil			

RECEIVED

MAY 21 2013

Equus Beds Groundwater
Administration District No. 2

7 CONTRACTOR'S OR LANDOWNER'S CERTIFICATION: This water well was plugged under my jurisdiction and completed on (mo/day/year) 5/7/2013 and this record is true to the best of my knowledge and belief. Kansas Water Well Contractor's License No. _____ This Water Well Record was completed on (mo/day/year) 5/8/2013 under the business name of Orvin E. Voth by (signature) Orvin E. Voth

INSTRUCTIONS: Use typewriter or ballpoint pen. Please press firmly and print clearly. Please fill in blanks, underline or circle the correct answers. Send top three copies to Kansas Department of Health and Environment, Bureau of Water, Geology Section, 1000 SW Jackson St., Ste. 420, Topeka, Kansas 66612-1367. Telephone: 785/296-5524. Send one to Water Well Owner and retain one for your records. Visit us at <http://www.kdheks.gov/waterwell/index.html>.

Check one: ☐ White Copy ☐ Blue Copy ☐ Pink Copy