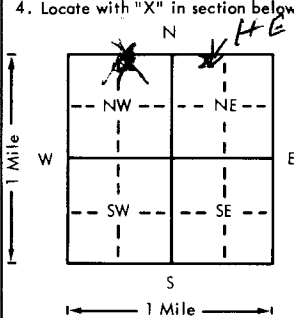


USE TYPEWRITER OR BALL
POINT PEN-PRESS FIRMLY,
PRINT CLEARLY.

WATER WELL RECORD
KSA 82a-1201-1215

Kansas Department of Health and
Environment-Division of Environment
(Water well Contractors)
Topeka, Kansas 66620

1. Location of well:		County PAWNEE	Fraction NE 1/4 NW 1/4 NE 1/4	Section number 25	Township number T 21	Range number S R 20	EW
2. Distance and direction from nearest town or city: 1 MILE NORTH 2 3/4 MILES WEST FROM BURDETT Street address of well location if in city:				3. Owner of well: JOHN THOMPSON R.R. or street: City, state, zip code: BURDETT, KANSAS 67523			
4. Locate with "X" in section below:		Sketch map:		6. Bore hole dia. 8 in. Completion date 1/14/78 Well depth 72 ft.			
				7. <input checked="" type="checkbox"/> Cable tool <input checked="" type="checkbox"/> Rotary <input type="checkbox"/> Driven <input type="checkbox"/> Dug <input type="checkbox"/> Hollow rod <input type="checkbox"/> Jetted <input type="checkbox"/> Bored <input type="checkbox"/> Reverse rotary			
5. Type and color of material		From To		8. Use: <input checked="" type="checkbox"/> Domestic <input type="checkbox"/> Public supply <input type="checkbox"/> Industry <input type="checkbox"/> Irrigation <input type="checkbox"/> Air conditioning <input type="checkbox"/> Stock <input type="checkbox"/> Lawn <input type="checkbox"/> Oil field water <input type="checkbox"/> Other			
FILL DIRT AND BLACK TOPSOIL		0 50		9. Casing: Material <input type="checkbox"/> Height: Above or below surface 34 in. Threaded <input type="checkbox"/> Welded <input checked="" type="checkbox"/> Surface 34 in. RMP <input type="checkbox"/> PVC <input checked="" type="checkbox"/> Weight 14 lbs./ft. Dia. 5 in. to 62 ft. depth Wall Thickness: inches or Dia. 5 in. to 62 ft. depth gage No. SCH. 40			
BROWN CLAY		5 36		10. Screens: Manufacturer's name SOLD BY PUMPCO Type PVC Dia. 5" Slot/gauze 1/16 Length 10 Set between 62 ft. and 72 ft. ft. and ft. Gravel pack YES Size range of material # 1			
BLUE CLAY		36 55		11. Static water level: 49 ft. below land surface Date 1/14/78			
TANCLAY (SOFT)		55 58		12. Pumping level below land surfaces: 51 ft. after 5 hrs. pumping 15 g.p.m. ft. after hrs. pumping g.p.m. Estimated maximum yield 60-80 g.p.m.			
GOOD CLEAN SAND		58 68		13. Water sample submitted: 49 mo./day/yr. Yes <input checked="" type="checkbox"/> No <input type="checkbox"/> Date 1/14/78			
TAN CLAY		68 76		14. Well head completion: <input checked="" type="checkbox"/> Pitless adapter 14 inches above grade			
FINE SILTY BROWN SAND		76 97		15. Well grouted? YES With: <input checked="" type="checkbox"/> Neat cement <input type="checkbox"/> Bentonite <input type="checkbox"/> Concrete Depth: From -4 ft. to -15 ft.			
YELLOW CLAY		97 100		16. Nearest source of possible contamination: SOUTH Direction SOUTH Type SEWER LINES Well disinfected upon completion? <input checked="" type="checkbox"/> Yes <input type="checkbox"/> No			
				17. Pump: RED Not installed Manufacturer's name RED Model number 9DP051 HP 1/2 Volts 230 Length of drop pipe 65 ft. capacity 9 g.p.m. Type: <input checked="" type="checkbox"/> Submersible <input type="checkbox"/> Turbine <input type="checkbox"/> Jet <input type="checkbox"/> Reciprocating <input type="checkbox"/> Centrifugal <input type="checkbox"/> Other			
				18. Elevation:			
				19. Remarks: OWNER WILL RUN SLAB AROUND TOP OF WELL HE KNOWS THIS IS A CONTAMINATION SLAB HAS BEEN RUN SEWER <i>Dean Waterhouse</i>			
				20. Water well contractor's certification: This well was drilled under my jurisdiction and this report is true to the best of my knowledge and belief. DEAN WATERHOUSE DRILLING 243 Business name HANSTON, KANSAS License No. Address Dean Waterhouse Date 1/15/78 Signed <i>Dean Waterhouse</i> Authorized representative			

Forward the white, blue and pink copies to the Department of Health and Environment

Farm WWC-5