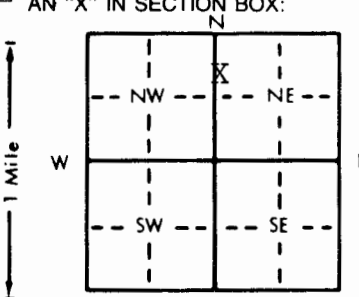


1 LOCATION OF WATER WELL: Fraction Section Number Township Number Range Number
 County: **Hodgeman** SW 1/4 NW 1/4 NE 1/4 18 T 21 S R 21 E/W

Distance and direction from nearest town or city street address of well if located within city?
 From NW Corner of Hanston - 6 1/4 Miles North, 3 Miles East, 4,260 Ft. North & 2,600 Ft. West

2 WATER WELL OWNER: **Ralph Ewy**
 RR#, St. Address, Box #: **Route 1 - Box 57** Board of Agriculture, Division of Water Resources
 City, State, ZIP Code: **Hanston, Kansas 67849** Application Number: **6632**

3 LOCATE WELL'S LOCATION WITH AN "X" IN SECTION BOX:

 4 DEPTH OF COMPLETED WELL: **120** ft. ELEVATION:
 Depth(s) Groundwater Encountered 1. ft. 2. ft. 3. ft.
 WELL'S STATIC WATER LEVEL: **50** ft. below land surface measured on mo/day/yr **7-15-94**
 Pump test data: Well water was ft. after hours pumping gpm
 Est. Yield gpm: Well water was ft. after hours pumping gpm
 Bore Hole Diameter: **30** in. to **120** in. to ft. and in. to ft.
 WELL WATER TO BE USED AS:
 5 Public water supply 8 Air conditioning 11 Injection well
 1 Domestic 3 Feedlot 6 Oil field water supply 9 Dewatering 12 Other (Specify below)
 2 Irrigation 4 Industrial 7 Lawn and garden only 10 Monitoring well
 Was a chemical/bacteriological sample submitted to Department? Yes.....No **X**.....; If yes, mo/day/yr sample was submitted
 Water Well Disinfected? Yes No **X**

5 TYPE OF BLANK CASING USED:
 1 Steel 3 RMP (SR) 5 Wrought iron 8 Concrete tile CASING JOINTS: Glued **X** Clamped
 2 PVC 4 ABS 6 Asbestos-Cement 9 Other (specify below) Welded
 7 Fiberglass Threaded.....
 Blank casing diameter **16** in. to **75** ft., Dia in. to ft., Dia in. to ft.
 Casing height above land surface: **12** in., weight **16.15** lbs./ft. Wall thickness or gauge No. **.500**
 TYPE OF SCREEN OR PERFORATION MATERIAL:
 1 Steel 3 Stainless steel 5 Fiberglass 7 PVC 10 Asbestos-cement
 2 Brass 4 Galvanized steel 6 Concrete tile 8 RMP (SR) 11 Other (specify)
 12 None used (open hole)
 SCREEN OR PERFORATION OPENINGS ARE:
 1 Continuous slot 3 Mill slot 5 Gauzed wrapped 8 Saw cut 11 None (open hole)
 2 Louvered shutter 4 Key punched 6 Wire wrapped 9 Drilled holes
 7 Torch cut 10 Other (specify)
 SCREEN-PERFORATED INTERVALS: From **75** ft. to **120** ft., From ft. to ft.
 From ft. to ft., From ft. to ft.
 GRAVEL PACK INTERVALS: From **20** ft. to **120** ft., From ft. to ft.
 From ft. to ft., From ft. to ft.

6 GROUT MATERIAL: 1 Neat cement 2 Cement grout 3 Bentonite 4 Other
 Grout Intervals: From **0** ft. to **20** ft., From ft. to ft., From ft. to ft.
 What is the nearest source of possible contamination:
 1 Septic tank 4 Lateral lines 7 Pit privy 10 Livestock pens 14 Abandoned water well
 2 Sewer lines 5 Cess pool 8 Sewage lagoon 11 Fuel storage 15 Oil well/Gas well
 3 Watertight sewer lines 6 Seepage pit 9 Feedyard 12 Fertilizer storage 16 Other (specify below)
 13 Insecticide storage
 Direction from well? **South** How many feet? **290**

FROM	TO	LITHOLOGIC LOG	FROM	TO	PLUGGING INTERVALS
		See attached log			

7 CONTRACTOR'S OR LANDOWNER'S CERTIFICATION: This water well was (1) constructed, (2) reconstructed, or (3) plugged under my jurisdiction and was completed on (mo/day/year) **7-15-94** and this record is true to the best of my knowledge and belief. Kansas
 Water Well Contractor's License No. **208** This Water Well Record was completed on (mo/day/yr) **8-1-94**
 under the business name of **Minter-Wilson Drilling Co., Inc.** by (signature) *Nora Keller*

INSTRUCTIONS: Use typewriter or ball point pen. PLEASE PRESS FIRMLY and PRINT clearly. Please fill in blanks, underline or circle the correct answers. Send top three copies to Kansas Department of Health and Environment, Bureau of Water, Topeka, Kansas 66620-0001. Telephone: 913-296-5545. Send one to WATER WELL OWNER and retain one for your records.

OFFICE USE ONLY
T
R
E/W
SEC.

*The
Professionals*

MINTER-WILSON DRILLING CO.

INCORPORATED

Irrigation
and Domestic
Water Systems
Complete Installation
and Repairing

Phone 276-8269 • P.O. Box A • GARDEN CITY, KANSAS 67846

Ralph Ewy
Hodgeman County
6-27-94

Location: NE $\frac{1}{4}$ 18-21-21
From Hanston - 7 Miles North, 2 $\frac{1}{2}$ Miles
East, 1020 Ft. South
(300 Ft. North of old well)

Static Water Level - About 50'

Test #1

	0'	to	2'	-	Top soil
C1	2'	to	23'	-	Brown clay
17	23'	to	49'	-	Fine to medium sand and gravel - loose
C1	49'	to	71'	-	Blue clay
C7	71'	to	80'	-	Fine to medium sand - loose
17	80'	to	83'	-	Fine to medium sand and gravel - loose
C1	83'	to	91'	-	Brown clay
17	91'	to	95'	-	Fine to medium sand gravel - loose
C1	95'	to	100'	-	Brown clay
C7	100'	to	103'	-	Fine to medium sand - loose
17	103'	to	113'	-	Fine to medium sand and gravel - coarse yellow rock mixed - loose
C1	113'	to	115'	-	Yellow clay
19	115'	to	125'	-	Shale

