WATER WELL RECORD Form WWC-5 KSA 82a-1212

LOCATION OF WATER WELL:	Fraction	Section Number	Township Number	Range Number
unty: HODGEMAN	NW ¼ NW ¼ SE ¼	25	T 21 S	R 21 E/W

stance and direction from nearest town or city street address of well if located within city? 2½ mile west of Burdett, Ks. 67523

WATER WELL OWNER: LAWRENCE & ELEANOR BAUER

R#, St. Address, Box # : Box 208

y, State, ZIP Code : Burdett, Ks. 67523

Board of Agriculture, Division of Water Resources
Application Number: V.R. FILE# 007

LOCATE WELL'S LOCATION WITH AN "X" IN SECTION BOX:

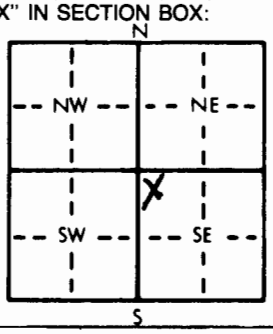

4 DEPTH OF COMPLETED WELL 129 ft. ELEVATION: VALLEY

Depth(s) Groundwater Encountered 1. 48 ft. 2. 80 ft. 3. 120 ft.

WELL'S STATIC WATER LEVEL 48 ft. below land surface measured on mo/day/yr AUG. 9 1982

Pump test data: Well water was 75 ft. after 30 hours pumping 850 gpm

Est. Yield 1000 gpm: Well water was ft. after hours pumping gpm

Bore Hole Diameter 30 in. to 129 ft., and in. to ft.

WELL WATER TO BE USED AS: 1 Domestic 2 Irrigation 3 Feedlot 4 Industrial 5 Public water supply 6 Oil field water supply 7 Lawn and garden only 8 Air conditioning 9 Dewatering 10 Observation well 11 Injection well 12 Other (Specify below)

Was a chemical/bacteriological sample submitted to Department? Yes ..... No XX ; If yes, mo/day/yr sample was submitted

Water Well Disinfected? Yes No XX

TYPE OF BLANK CASING USED: 1 Steel 2 PVC 3 RMP (SR) 4 ABS 5 Wrought iron 6 Asbestos-Cement 7 Fiberglass 8 Concrete tile 9 Other (specify below)

CASING JOINTS: Glued Clamped Welded XX Threaded

ank casing diameter 16 in. to 49 ft., Dia in. to ft., Dia in. to ft.

sing height above land surface 12 in., weight lbs./ft. Wall thickness or gauge No. .188 wall

PE OF SCREEN OR PERFORATION MATERIAL: 1 Steel 2 Brass 3 Stainless steel 4 Galvanized steel 5 Fiberglass 6 Concrete tile 7 PVC 8 RMP (SR) 9 ABS 10 Asbestos-cement 11 Other (specify) 12 None used (open hole)

REEN OR PERFORATION OPENINGS ARE: 1 Continuous slot 2 Louvered shutter 3 Mill slot 4 Key punched 5 Gauzed wrapped 6 Wire wrapped 7 Torch cut 8 Saw cut 9 Drilled holes 10 Other (specify) 11 None (open hole)

REEN-PERFORATED INTERVALS: From 49 ft. to 129 ft., From ft. to ft.
From ft. to ft., From ft. to ft.

GRAVEL PACK INTERVALS: From 10 ft. to 129 ft., From ft. to ft.
From ft. to ft., From ft. to ft.

GROUT MATERIAL: 1 Neat cement 2 Cement grout 3 Bentonite 4 Other

out Intervals: From plus 1 ft. to 10 ft., From ft. to ft., From ft. to ft.

hat is the nearest source of possible contamination: 1 Septic tank 2 Sewer lines 3 Watertight sewer lines 4 Lateral lines 5 Cess pool 6 Seepage pit 7 Pit privy 8 Sewage lagoon 9 Feedyard 10 Livestock pens 11 Fuel storage 12 Fertilizer storage 13 Insecticide storage 14 Abandoned water well 15 Oil well/Gas well 16 Other (specify below)

rection from well? EAST How many feet? 80

FROM	TO	LITHOLOGIC LOG	FROM	TO	LITHOLOGIC LOG
0	4	black topsoil			
4	26	brown clay			
26	70	sand			
70	80	blue clay			
80	92	sand			
92	98	blue clay			
98	120	fine sand			
120	128	course dark sand & rock			
128	154	blue shale			

CONTRACTOR'S OR LANDOWNER'S CERTIFICATION: This water well was (1) constructed, (2) reconstructed, or (3) plugged under my jurisdiction and was mpleted on (mo/day/year) AUG. 14, 1982 and this record is true to the best of my knowledge and belief. Kansas ater Well Contractor's License No. 243 This Water Well Record was completed on (mo/day/yr) AUG. 27, 1982

der the business name of DEAN WATERHOUSE DRILLING by (signature) Dean Waterhouse

STRUCTIONS: Use typewriter or ball point pen, *PLEASE PRESS FIRMLY* and *PRINT* clearly. Please fill in blanks, underline or circle the correct answers. Send top ee copies to Kansas Department of Health and Environment, Division of Environment, Environmental Geology Section, Topeka, KS 66620. Send one to WATER WELL WNER and retain one for your records.

OFFICE USE ONLY T 21 R 21 E/W SEC. 25 NW ¼ NW ¼ SE ¼