


1 LOCATION OF WATER WELL: County: Hodgeman Fraction NW 1/4 NW 1/4 SE 1/4 Section Number 25 Township Number T 21 S Range Number R 21W E/W

Distance and direction from nearest town or city street address of well if located within city?
3 E, 1 N of Gray, Kansas

2 WATER WELL OWNER: Lawrence Bauer
 RR#, St. Address, Box # : Burdett, Kansas 67523 Board of Agriculture, Division of Water Resources
 City, State, ZIP Code : Application Number: HG0007

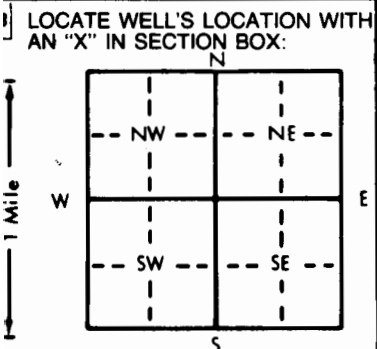

4 DEPTH OF COMPLETED WELL: 126 ft. ELEVATION: Unknown
 Depth(s) Groundwater Encountered 1. 51 ft. 2. _____ ft. 3. _____ ft.
 WELL'S STATIC WATER LEVEL: 51 ft. below land surface measured on mo/day/yr 6/29/93
 Pump test data: Well water was _____ ft. after _____ hours pumping _____ gpm
 Est. Yield 1,000 gpm: Well water was _____ ft. after _____ hours pumping _____ gpm
 Bore Hole Diameter: 30 in. to 126 in. to _____ in. to _____ in.
 WELL WATER TO BE USED AS:
 5 Public water supply 8 Air conditioning 11 Injection well
 1 Domestic 3 Feedlot 6 Oil field water supply 9 Dewatering 12 Other (Specify below)
2 Irrigation 4 Industrial 7 Lawn and garden only 10 Monitoring well
 Was a chemical/bacteriological sample submitted to Department? Yes _____ No _____; If yes, mo/day/yr sample was submitted _____
 Water Well Disinfected? Yes _____ No _____

5 TYPE OF BLANK CASING USED:
 1 Steel 3 RMP (SR) 5 Wrought iron 8 Concrete tile CASING JOINTS: Glued _____ Clamped _____
 2 PVC 4 ABS 6 Asbestos-Cement 9 Other (specify below) Welded _____
 7 Fiberglass Threaded _____
 Blank casing diameter: 16 in. to 106 ft., Dia _____ in. to _____ ft., Dia _____ in. to _____ ft.
 Casing height above land surface: 12 in., weight X 16.5 lbs./ft. Wall thickness or gauge No. Sch. 40

TYPE OF SCREEN OR PERFORATION MATERIAL:
 1 Steel 3 Stainless steel 5 Fiberglass 7 PVC 10 Asbestos-cement
 2 Brass 4 Galvanized steel 6 Concrete tile 8 RMP (SR) 11 Other (specify) _____
 12 None used (open hole)

SCREEN OR PERFORATION OPENINGS ARE:
 1 Continuous slot 3 Mill slot 5 Gauzed wrapped 8 Saw cut 11 None (open hole)
 2 Louvered shutter 4 Key punched 6 Wire wrapped 9 Drilled holes
 7 Torch cut 10 Other (specify) _____

SCREEN-PERFORATED INTERVALS: From 106 ft. to 126 ft., From _____ ft. to _____ ft.
 From 80 ft. to 90 ft., From _____ ft. to _____ ft.
 GRAVEL PACK INTERVALS: From 20 ft. to 126 ft., From _____ ft. to _____ ft.
 From _____ ft. to _____ ft., From _____ ft. to _____ ft.

6 GROUT MATERIAL: 1 Neat cement 2 Cement grout 3 Bentonite 4 Other _____
 Grout intervals: From 0 ft. to 20 ft., From _____ ft. to _____ ft., From _____ ft. to _____ ft.

What is the nearest source of possible contamination:
 1 Septic tank 4 Lateral lines 7 Pit privy 10 Livestock pens 14 Abandoned water well
 2 Sewer lines 5 Cess pool 8 Sewage lagoon 11 Fuel storage 15 Oil well/Gas well
 3 Watertight sewer lines 6 Seepage pit 9 Feedyard 12 Fertilizer storage 16 Other (specify below)
Middle of field
 Direction from well? _____ How many feet? _____

FROM	TO	LITHOLOGIC LOG	FROM	TO	PLUGGING INTERVALS
0	50	Clay			
50	90	Sand and gravel			
90	106	Clay			
106	126	Sand and gravel			

7 CONTRACTOR'S OR LANDOWNER'S CERTIFICATION: This water well was (1) constructed, (2) reconstructed, or (3) plugged under my jurisdiction and was completed on (mo/day/year) 6/29/93 and this record is true to the best of my knowledge and belief. Kansas Water Well Contractor's License No. 186. This Water Well Record was completed on (mo/day/yr) 7/31/93 under the business name of Kelly's Water Well Service, Inc. by (signature) [Signature]

INSTRUCTIONS: Use typewriter or ball point pen. PLEASE PRESS FIRMLY and PRINT clearly. Please fill in blanks, underline or circle the correct answers. Send top three copies to Kansas Department of Health and Environment, Bureau of Water, Topeka, Kansas 66620-0001. Telephone: 913-296-5545. Send one to WATER WELL OWNER and retain one for your records.