WATER WELL RECORD Form WWC-5 KSA 82a-1212

LOCATION OF WATER WELL: County: HODGMAN [redacted]	Fraction NE ¼ NE ¼ NW ¼	Section Number 26	Township Number T 21 S	Range Number R 21 [redacted]/W

Distance and direction from nearest town or city street address of well if located within city? 4 mile West and 1 mile North of [redacted] BURDETT,KS.

WATER WELL OWNER: FIVE STAR FARMS
RR#, St. Address, Box # : RT. 2 BOX 52
City, State, ZIP Code : BURDETT,KS. 67523

Board of Agriculture, Division of Water Resources Application Number:

LOCATE WELL'S LOCATION WITH AN "X" IN SECTION BOX:

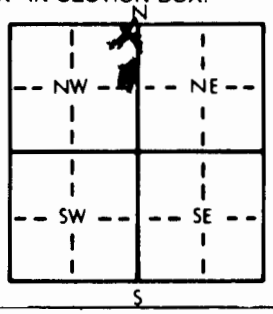

4 DEPTH OF COMPLETED WELL 84 ft. ELEVATION: VALLEY

Depth(s) Groundwater Encountered 1. 41 ft. 2. 68 ft. 3. ft.

WELL'S STATIC WATER LEVEL 51 ft. below land surface measured on mo/day/yr [redacted] MARCH 15,1991

Pump test data: Well water was 54 ft. after 5 hours pumping 36 gpm

Est. Yield 90 gpm: Well water was ft. after hours pumping gpm

Bore Hole Diameter 8 in. to 90 ft., and in. to ft.

WELL WATER TO BE USED AS: 1 Domestic 3 Feedlot 5 Public water supply 6 Oil field water supply 7 Lawn and garden only 8 Air conditioning 9 Dewatering 10 Monitoring well 11 Injection well 12 Other (Specify below) 2 Irrigation 4 Industrial

Was a chemical/bacteriological sample submitted to Department? Yes ..... No XX ; If yes, mo/day/yr sample was submitted

Water Well Disinfected? Yes XX No

TYPE OF BLANK CASING USED: 1 Steel 2 PVC 3 RMP (SR) 4 ABS 5 Wrought iron 6 Asbestos-Cement 7 Fiberglass 8 Concrete tile 9 Other (specify below)

CASING JOINTS: Glued XX Clamped Welded Threaded

Blank casing diameter [redacted] 5 in. to 74 ft., Dia in. to ft., Dia in. to ft.

Casing height above land surface 12 in., weight 2.87 lbs./ft. Wall thickness or gauge No. .265

TYPE OF SCREEN OR PERFORATION MATERIAL: 1 Steel 2 Brass 3 Stainless steel 4 Galvanized steel 5 Fiberglass 6 Concrete tile 7 PVC 8 RMP (SR) 9 ABS 10 Asbestos-cement 11 Other (specify) 12 None used (open hole)

SCREEN OR PERFORATION OPENINGS ARE: 1 Continuous slot 2 Louvered shutter 3 Mill slot 4 Key punched 5 Gauzed wrapped 6 Wire wrapped 7 Torch cut 8 Saw cut 9 Drilled holes 10 Other (specify) 11 None (open hole)

SCREEN-PERFORATED INTERVALS: From 74 ft. to 84 ft., From ft. to ft.
From ft. to ft., From ft. to ft.

GRAVEL PACK INTERVALS: From 69 ft. to 84 ft., From ft. to ft.
From 63 ft. to 24 ft., From ft. to ft.

GROUT MATERIAL: 1 Neat cement 2 Cement grout 3 Bentonite 4 Other

Grout Intervals: From 63 ft. to 69 ft., From 24 ft. to 4 ft., From ft. to ft.

What is the nearest source of possible contamination: 1 Septic tank 2 Sewer lines 3 Watertight sewer lines 4 Lateral lines 5 Cess pool 6 Seepage pit 7 Pit privy 8 Sewage lagoon 9 Feedyard 10 Livestock pens 11 Fuel storage 12 Fertilizer storage 13 Insecticide storage 14 Abandoned water well 15 Oil well/Gas well 16 Other (specify below) CONTAMINATED WATER WELL

Direction from well? SOUTH How many feet? 600

FROM	TO	LITHOLOGIC LOG	FROM	TO	PLUGGING INTERVALS
0	4	black topsoil			
4	35	tan clay			
35	41	grey clay			
41	65	sand			
65	68	grey clay			
68	86	sand			
86	90	rainbow clay			

CONTRACTOR'S OR LANDOWNER'S CERTIFICATION: This water well was (1) constructed, (2) reconstructed, or (3) plugged under my jurisdiction and was completed on (mo/day/year) [redacted] MAY 21, 1991 and this record is true to the best of my knowledge and belief. Kansas Water Well Contractor's License No. 243 This Water Well Record was completed on (mo/day/yr) MAY [redacted] 21,1991 under the business name of DEAN WATERHOUSE DRILLING by (signature) Dean Waterhouse

INSTRUCTIONS: Use typewriter or ball point pen. *PLEASE PRESS FIRMLY* and *PRINT* clearly. Please fill in blanks, underline or circle the correct answers. Send top three copies to Kansas Department of Health and Environment, Bureau of Water, Topeka, Kansas 66620-7320. Telephone: 913-296-5545. Send one to WATER WELL OWNER and retain one for your records.

OFFICE USE ONLY T R E/W SEC. ¼ ¼ ¼