USE TYPEWRITER OR BALL POINT PEN-PRESS FIRMLY, PRINT CLEARLY.

BURDETT

WATER WELL RECORD
KSA 82a-1201-1215

Kansas Department of Health and Environment-Division of Environment
(Water well Contractors)
Topeka, Kansas 66620

BD (center)

1. Location of well:	County	Fraction	Section number	Township number	Range number
	Hodgeman	C 1/4 SE 1/4 NW 1/4	27	T 21 S	R 21 E/W

2. Distance and direction from nearest town or city: 4 W. 3/4 N. 3/4 W.
Street address of well location if in city: Burdette, Kans

3. Owner of well: DUNNE-Gardner Petroleum
R.R. or street: 200 W. Douglas
City, state, zip code: Wichita, Ks.

4. Locate with "X" in section below:

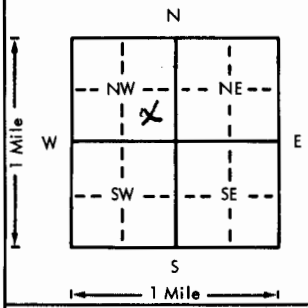

Sketch map:

5. Type and color of material	From	To
TopSoil-Clay	0	110
Sand Rock-Clay	110	130
Sand Rock	130	210
BROCK?		

(Use a second sheet if needed)

6. Bore hole dia. 7 in. Completion date 11-14-75
Well depth 210 ft.

7. __ Cable tool X Rotary __ Driven __ Dug
__ Hollow rod __ Jetted __ Bored __ Reverse rotary

8. Use: __ Domestic __ Public supply __ Industry
__ Irrigation __ Air conditioning __ Stock
__ Lawn X Oil field water __ Other

X Casing: Material ____ Height: Above or below
Threaded ____ Welded ____ Surface 12 in.
RMP ____ PVC X Weight 2 lbs./ft.
Dia. 4 in. to ____ ft. depth Wall Thickness: inches or
Dia. ____ in. to ____ ft. depth X Gage No. Sch 40

10. Screen: Manufacturer's name MPI
Type PVC Dia. 4"
Slot/gauze 1/8" Length 40
Set between 170 ft. and 210 ft.
____ ft. and ____ ft.
Gravel pack? X Size range of material 1/8-3/4"

11. Static water level: mo./day/yr.
60 ft. below land surface Date 11-14-75

12. Pumping level below land surfaces:
____ ft. after ____ hrs. pumping ____ g.p.m.
____ ft. after ____ hrs. pumping ____ g.p.m.
Estimated maximum yield 40 g.p.m.

13. Water sample submitted: mo./day/yr.
__ Yes X No Date ____

14. Well head completion:
__ Pitless adapter 12 Inches above grade

15. Well grouted? X
With: __ Neat cement X Bentonite __ Concrete
Depth: From 0 ft. to 10 ft.

16. Nearest source of possible contamination:
ft. 70 Direction SE Type Oil Test
Well disinfected upon completion? __ Yes __ No

17. Pump: X Not installed
Manufacturer's name ____
Model number ____ HP ____ Volts ____
Length of drop pipe ____ ft. capacity ____ g.p.m.
Type:
__ Submersible __ Turbine
__ Jet __ Reciprocating
__ Centrifugal __ Other

18. Elevation:
Topography:
__ Hill
__ Slope
X Upland
__ Valley

19. Remarks:
2145
TOPO

20. Water well contractor's certification:
This well was drilled under my jurisdiction and this report is true to the best of my knowledge and belief.
Business name Kelly's Water Well Ser License No. 186
Address R 2 Great Bend, KS
Signed Kelly Price Date 11-20-75
Authorized representative

T 21 R 21 E/W Sec 27 1/4 SE 1/4 NW 1/4

Forward the white, blue and pink copies to the Department of Health and Environment

Form WWC-5

MI-1023