

USE TYPEWRITER OR BALL POINT PEN-PRESS FIRMLY, PRINT CLEARLY.

BURDETT

T R EW sec 1/4 1/4 1/4 No.


WATER WELL RECORD  
KSA 82a-1201-1215

Kansas State Dept. Of Health  
(Water Well Contractors)  
Forbes-Bldg. 740  
Topeka, Kansas 66620

ABD

1 Location of well: County HOPKINSON Township name MARENDALE Section number 36 Town number 21 Range number 21

Distance and direction from nearest town or city: 2 1/2 MILES WEST 3 Owner of well: ROY KLEIN  
1/8 MILE SOUTH OF BURDETT KANS  
Street address of well location if in city: BURDETT KANSAS

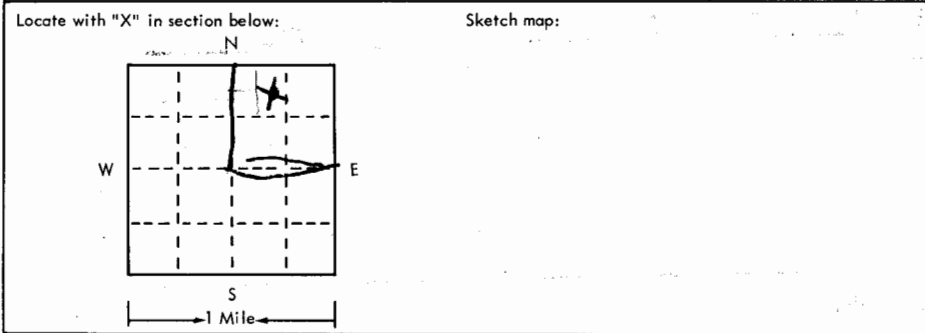

4 Well depth: 60 ft. Date of completion: 22 APRIL  
Well diameter 5 in.

5  Cable tool  Rotary  Driven  Dug  
 Hollow rod  Jetted  Bored  Reverse rotary

6 Use:  Domestic  Public supply  Industry  
 Irrigation  Air conditioning  Commercial  
 Test well

7 Casing: Material STEEL Height: above/below  
Threaded  Welded  Surface 14 in.  
Diam. 5 1/2 in. Weight 250 LB/100 FT  
to 49 ft. depth Drive shoe?  Yes  No

2	Type and color of material	From	To
	TOP SOIL BLACK	0	6
	TAN CLAY	6	24
	SANDY TAN CLAY	24	30
	RED SAND	30	38
	GOOD CLEAN MEDIUM SAND	38	60
	LIGHT COLORED CLAY	60	73
	RED SAND	73	100
	BRICK 60'		
	42		
	18' salt flat		
	in Alluvium		

8 Screen: Manufacturer JESSE + LOWELL  
Type 250 Dia. 5"  
Slot/gauze \_\_\_\_\_ Length 10  
Set between 49 ft. and 69 ft.  
Fittings: Gravel pack  Yes  No Size range of material 1/8 DOWN

9 Static water level: 42 ft. below land surface Date 22 APRIL

10 Pumping level below land surfaces:  
40 ft. after \_\_\_\_\_ hrs. pumping 15 g.p.m.  
\_\_\_\_\_ ft. after \_\_\_\_\_ hrs. pumping \_\_\_\_\_ g.p.m.  
Estimated maximum yield 300 g.p.m.

11 Water sample submitted:  
 Yes  No Date \_\_\_\_\_

12 Well head completion:  
 Pitless adapter  Inches above grade

13 Well grouted?  Yes  No  
 Neat cement  Bentonite  ~~SALT~~  
Depth: From 3 ft. to 15 ft.

14 Nearest source of possible contamination:  
ft. 200 Direction SE Type SEPTIC TANK  
Well disinfected upon completion?  Yes  No

15 Pump:  Not installed  
Manufacturer's name REDA  
Model number 909081 HP 1/2 Volts 4  
Length of drop pipe \_\_\_\_\_ ft. capacity 100 g.p.m.  
Type:  
 Submersible  Turbine  
 Jet  Reciprocating  
 Centrifugal  Other

16 Remarks: elevation

Topography:  
 Hill  
 Slope  
 Upland  
 Valley

TOPG

2110  
60  
2050

17 Water well contractor's certification:  
This well was drilled under my jurisdiction and this report is true to the best of my knowledge and belief.

DEAN WATERHOUSE DRILLING  
Business name License No. 243  
Address HANSTON KANSAS  
Signed Dean Waterhouse Date 15-6-75  
Authorized representative