

**WATER WELL RECORD Form WWC-5**

Division of Water Resources App. No.


6632

Well ID

Original Record  Correction  Change in Well Use

**1 LOCATION OF WATER WELL:** County: Hodgeman Fraction 1/4 1/4 NC 1/4 NE 1/4 Section Number 18 Township Number T 21 S Range Number R 21  E  W

**2 WELL OWNER:** Last Name: Ewy First: Roger Street or Rural Address where well is located (if unknown, distance and direction from nearest town or intersection): If at owner's address, check here:   
 Business: RRE Trust Address: 404 E Adams City: Hanston State: KS ZIP: 67849  
 Address: 4 3/4 North, 1 1/4 West of Gray

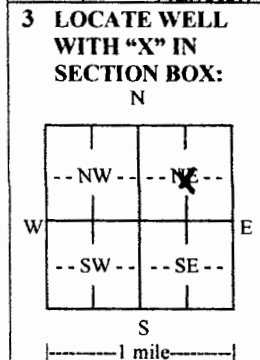

**4 DEPTH OF COMPLETED WELL:** 118 ft.  
 Depth(s) Groundwater Encountered: 1) 118 ft.  
 WELL'S STATIC WATER LEVEL: 44 ft.  
 below land surface, measured on (mo-day-yr) 4-27-18  
 Estimated Yield: 30 gpm  
 Bore Hole Diameter: 30 in. to 118 ft. and 30 in. to 118 ft.

**5 Latitude:** .....(decimal degrees)  
**Longitude:** .....(decimal degrees)  
 Horizontal Datum:  WGS 84  NAD 83  NAD 27  
 Source for Latitude/Longitude:  
 GPS (unit make/model: .....)  
 (WAAS enabled?  Yes  No)  
 Land Survey  Topographic Map  
 Online Mapper: .....  
**6 Elevation:** .....ft.  Ground Level  TOC  
 Source:  Land Survey  GPS  Topographic Map  
 Other .....

**7 WELL WATER TO BE USED AS:**

1. Domestic:  Household  Lawn & Garden  Livestock  
 2.  Irrigation  
 3.  Feedlot  
 4.  Industrial  
 5.  Public Water Supply: well ID .....  
 6.  Dewatering: how many wells? .....  
 7.  Aquifer Recharge: well ID .....  
 8.  Monitoring: well ID .....  
 9. Environmental Remediation: well ID .....  
 Air Sparge  Soil Vapor Extraction  
 Recovery  Injection  
 10.  Oil Field Water Supply: lease .....  
 11. Test Hole: well ID .....  
 Cased  Uncased  Geotechnical  
 12. Geothermal: how many bores? .....  
 a) Closed Loop  Horizontal  Vertical  
 b) Open Loop  Surface Discharge  Inj. of Water  
 13.  Other (specify): .....

Was a chemical/bacteriological sample submitted to KDHE?  Yes  No If yes, date sample was submitted: .....  
 Water well disinfected?  Yes  No

**8 TYPE OF CASING USED:**  Steel  PVC  Other ..... CASING JOINTS:  Glued  Clamped  Welded  Threaded  
 Casing diameter 16 in. to 118 ft., Diameter 16 in. to 118 ft., Diameter ..... in. to ..... ft.  
 Casing height above land surface 18 in. Weight Sch. 40 lbs./ft. Wall thickness or gauge No. ....

TYPE OF SCREEN OR PERFORATION MATERIAL:  
 Steel  Stainless Steel  Fiberglass  PVC  Other (Specify) .....  
 Brass  Galvanized Steel  Concrete tile  None used (open hole)  
 SCREEN OR PERFORATION OPENINGS ARE:  
 Continuous Slot  Mill Slot  Gauze Wrapped  Torch Cut  Drilled Holes  Other (Specify) .....  
 Louvered Shutter  Key Punched  Wire Wrapped  Saw Cut  None (Open Hole)  
 SCREEN-PERFORATED INTERVALS: From 112 ft. to 72 ft., From ..... ft. to ..... ft., From ..... ft. to ..... ft.  
 GRAVEL PACK INTERVALS: From 118 ft. to 20 ft., From ..... ft. to ..... ft., From ..... ft. to ..... ft.

**9 GROUT MATERIAL:**  Neat cement  Cement grout  Bentonite  Other .....  
 Grout Intervals: From ..... ft. to ..... ft., From 20 ft. to 0 ft., From ..... ft. to ..... ft.  
 Nearest source of possible contamination:  
 Septic Tank  Lateral Lines  Pit Privy  Livestock Pens  Insecticide Storage  
 Sewer Lines  Cess Pool  Sewage Lagoon  Fuel Storage  Abandoned Water Well  
 Watertight Sewer Lines  Seepage Pit  Feedyard  Fertilizer Storage  Oil Well/Gas Well  
 Other (Specify) None .....  
 Direction from well? ..... Distance from well? ..... ft.

10 FROM	TO	LITHOLOGIC LOG	FROM	TO	LITHO. LOG (cont.) or PLUGGING INTERVALS
0	3	Top soil	60	98	Gravel- med to large clean coarse
3	32	Brown clay			w/ broken rock
32	33	Gray clay	98	99	Gray clay streak
33	36	Sand & gravel- small med clean coarse	99	109	Sand & gravel- med to large coarse
36	38	Gravel- small med w/ heavy gray clay			w/ broken rock
		streaks	109	118	Fire clay
38	40	Tan clay	Notes:		
40	60	Sand & gravel- small med clean coarse			
		w/ broken rock			

**11 CONTRACTOR'S OR LANDOWNER'S CERTIFICATION:** This water well was  constructed,  reconstructed, or  plugged under my jurisdiction and was completed on (mo-day-year) 4-27-18 and this record is true to the best of my knowledge and belief. Kansas Water Well Contractor's License No. 134 This Water Well Record was completed on (mo-day-year) 5-14-18 under the business name of Rosencrantz Bemis Ent Inc Signature Clara Aelfs

Mail 1 white copy along with a fee of \$5.00 for each constructed well to: Kansas Department of Health and Environment, Bureau of Water, GWTS Section, 1000 SW Jackson St., Suite 420, Topeka, Kansas 66612-1367. Mail one to Water Well Owner and retain one for your records. Telephone 785-296-5524. Visit us at <http://www.kdheks.gov/waterwell/index.html> KSA 82a-1212 Revised 7/10/2015