


1 LOCATION OF WATER WELL: Fraction SW 1/4 NW 1/4 SE 1/4 Section Number xx 2 Township Number T 21 S Range Number R 22 EW

Distance and direction from nearest town or city street address of well if located within city?
 8 1/2 north of Hanston, Ks.

2 WATER WELL OWNER: Ray Lee
 RR#, St. Address, Box #: Box 186
 City, State, ZIP Code: Hanston, Ks. 67849
 Board of Agriculture, Division of Water Resources
 Application Number: 17,281

3 LOCATE WELL'S LOCATION WITH AN "X" IN SECTION BOX:

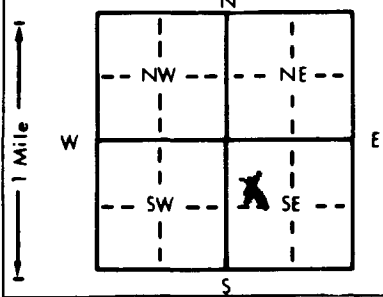

4 DEPTH OF COMPLETED WELL: 103 ft. ELEVATION:

Depth(s) Groundwater Encountered 1. ft. 2. ft. 3. ft.
 WELL'S STATIC WATER LEVEL . . . 52 ft. below land surface measured on mo/day/yr . . . 5-28-93
 Pump test data: Well water was ft. after hours pumping gpm
 Est. Yield . . . 750 . . . gpm: Well water was . . . 74 . . . ft. after . . . 2 hours pumping . . . 700 . . . gpm
 Bore Hole Diameter . . 28 in. to ft., and in. to ft.
 WELL WATER TO BE USED AS: 5 Public water supply 8 Air conditioning 11 Injection well
 1 Domestic 3 Feedlot 6 Oil field water supply 9 Dewatering 12 Other (Specify below)
 2 Irrigation 4 Industrial 7 Lawn and garden only 10 Monitoring well
 Was a chemical/bacteriological sample submitted to Department? Yes No x; If yes, mo/day/yr sample was sub-
 mitted Water Well Disinfected? Yes h+h No

5 TYPE OF BLANK CASING USED: 5 Wrought iron 8 Concrete tile CASING JOINTS: Glued . . . x . . . Clamped
 1 Steel 3 RMP (SR) 6 Asbestos-Cement 9 Other (specify below) Welded
 2 PVC 4 ABS 7 Fiberglass Threaded

Blank casing diameter . . . 16 in. to . . . 70 ft., Dia in. to ft., Dia in. to ft.
 Casing height above land surface 12 in., weight . . . SDR32.5 lbs./ft. Wall thickness or gauge No.

TYPE OF SCREEN OR PERFORATION MATERIAL: 7 PVC 10 Asbestos-cement
 1 Steel 3 Stainless steel 5 Fiberglass 8 RMP (SR) 11 Other (specify)
 2 Brass 4 Galvanized steel 6 Concrete tile 9 ABS 12 None used (open hole)

SCREEN OR PERFORATION OPENINGS ARE: 5 Gauzed wrapped 8 Saw cut 11 None (open hole)
 1 Continuous slot 3 Mill slot 6 Wire wrapped 9 Drilled holes
 2 Louvered shutter 4 Key punched 7 Torch cut 10 Other (specify)

SCREEN-PERFORATED INTERVALS: From . . . 70 ft. to . . . 103 ft., From ft. to ft.
 From ft. to ft., From ft. to ft.
 GRAVEL PACK INTERVALS: From . . . 20 ft. to . . . 103 ft., From ft. to ft.
 From ft. to ft., From ft. to ft.

6 GROUT MATERIAL: 1 Neat cement 2 Cement grout 3 Bentonite 4 Other
 Grout Intervals: From . . . 0 ft. to . . . 20 ft., From ft. to ft., From ft. to ft.

What is the nearest source of possible contamination:
 1 Septic tank 4 Lateral lines 7 Pit privy 10 Livestock pens 14 Abandoned water well
 2 Sewer lines 5 Cess pool 8 Sewage lagoon 11 Fuel storage 15 Oil well/Gas well
 3 Watertight sewer lines 6 Seepage pit 9 Feedyard 12 Fertilizer storage 16 Other (specify below)
 13 Insecticide storage none

Direction from well? How many feet?

FROM	TO	LITHOLOGIC LOG	FROM	TO	PLUGGING INTERVALS
0	3	Top soil			
3	27	Brown clay			
27	33	Fine sand			
33	50	Sand and gravel			
50	53 1/2	Brown clay			
53 1/2	57	Sand and gravel clean coarse loose			
57	68	Gray, green soft clay			
68	70	Fine sand			
70	79	Sand and gravel clean coarse loose			
79	85	Brown clay			
85	90	Sand and clay streaks			
90	93	Sandy clay & streaks of fine sand			
93	103	Sand and gravel clean coarse loose.			

7 CONTRACTOR'S OR LANDOWNER'S CERTIFICATION: This water well was (1) constructed, (2) reconstructed, or (3) plugged under my jurisdiction and was completed on (mo/day/year) . . . 6-30-93 and this record is true to the best of my knowledge and belief. Kansas Water Well Contractor's License No. 134 . . . This Water Well Record was completed on (mo/day/yr) . . . 7-6-93 under the business name of Rosencrantz-Bemis by (signature) Fredrick Hudson

INSTRUCTIONS: Use typewriter or ball point pen. PLEASE PRESS FIRMLY and PRINT clearly. Please fill in blanks, underline or circle the correct answers. Send top three copies to Kansas Department of Health and Environment, Bureau of Water, Topeka, Kansas 66620-0001. Telephone: 913-296-5545. Send one to WATER WELL OWNER and retain one for your records.