USE TYPEWRITER OR BALL POINT PEN-PRESS FIRMLY, PRINT CLEARLY.

WATER WELL RECORD
KSA 82a-1201-1215

Kansas Department of Health and Environment-Division of Environment
(Water well Contractors)
Topeka, Kansas 66620

1. Location of well:	County	Fraction	Section number	Township number	Range number
	HODGEMAN	SE 1/4 SE 1/4 NE 1/4	7	T 21 S	R 22 E/W

2. Distance and direction from nearest town or city: 4 west, 8 north of HANSTON KS.
Street address of well location if in city:

3. Owner of well: FRUSHER FARMS
R.R. or street:
City, state, zip code: JETMORE, KANSAS 67854

4. Locate with "X" in section below: Sketch map:

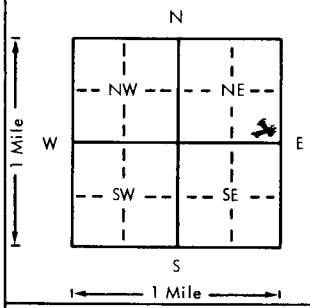

6. Bore hole dia. 8" in. Completion date
Well depth 50 ft. 10/1/80

7. __ Cable tool X Rotary __ Driven __ Dug
__ Hollow rod __ Jetted __ Bored __ Reverse rotary

8. Use: X Domestic __ Public supply __ Industry
__ Irrigation __ Air conditioning __ Stock
__ Lawn __ Oil field water __ Other

9. Casing: Material PVC
Threaded ___ Welded ___
RMP ___ PVC X
Dia. 5 in. to 30 ft. depth
Dia. ___ in. to ___ ft. depth
Height: Above or below Surface 18 in.
Weight ___ lbs./ft.
Wall Thickness: inches or gage No. 200 plus

5. Type and color of material	From	To
tan clay	0	8
tan sandy clay	8	30
sand	30	47
tan clay	47	48
blue shale	48	50

(Use a second sheet if needed)

10. Screen: Manufacturer's name jet stream
Type PVC Dia. 5"
Slot/gauze .040" Length 20'
Set between 30' ft. and 50' ft.
___ ft. and ___ ft.
Gravel pack? yes Size range of material #1

11. Static water level: mo./day/yr.
24 ft. below land surface Date 10/1/80

12. Pumping level below land surfaces:
26 ft. after 4 hrs. pumping 12 g.p.m.
___ ft. after ___ hrs. pumping ___ g.p.m.
Estimated maximum yield 120 plus g.p.m.

13. Water sample submitted: mo./day/yr.
__ Yes X No Date

14. Well head completion:
X Pitless adapter 18 Inches above grade

15. Well grouted? yes
With: X Neat cement ___ Bentonite ___ Concrete
Depth: From -3 ft. to -15 ft.

16. Nearest source of possible contamination:
ft. 87 Direction west Type corral
Well disinfected upon completion? X Yes ___ No

17. Pump: ___ Not installed
Manufacturer's name REDA
Model number 9D9P050 HP 1/2 Volts 115
Length of drop pipe 42 ft. capacity 9 g.p.m.
Type:
X Submersible ___ Turbine
___ Jet ___ Reciprocating
___ Centrifugal ___ Other

T 28 R 22 W Sec 7 SE SE NE 1/4 1/4 1/4

18. Elevation:
Topography:
___ Hill
___ Slope
X Upland
___ Valley

19. Remarks:

20. Water well contractor's certification:
This well was drilled under my jurisdiction and this report is true to the best of my knowledge and belief.
DEAN WATERHOUSE DRILLING 288
Business name License No.
Address HANSTON, KANSAS 67849
Signed Dean Waterhouse Date 10/13/80
Authorized representative

Forward the white, blue and pink copies to the Department of Health and Environment

Form WWC-5

MI-1023