


1 LOCATION OF WATER WELL: County: Hodgeman Fraction: SW 1/4 SW 1/4 NE 1/4 Section Number: 10 Township Number: T 21 S Range Number: R 22 W

Distance and direction from nearest town or city street address of well if located within city?  
8 North and 1 1/2 West of Hanston, Kansas

2 WATER WELL OWNER: Deana Schlereth  
 RR#, St. Address, Box #: Rt. 1  
 City, State, ZIP Code: Jetmore, Kansas 67854  
 Board of Agriculture, Division of Water Resources  
 Application Number: ---

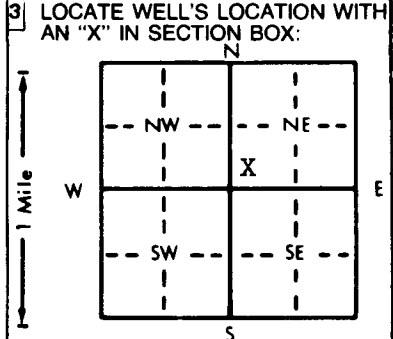

4 DEPTH OF COMPLETED WELL: 320 ft. ELEVATION: Slope  
 Depth(s) Groundwater Encountered: 1. Not available 2.          ft. 3.          ft.  
 WELL'S STATIC WATER LEVEL: 110 ft. below land surface measured on mo/day/yr April 22, 1992  
 Pump test data: Well water was          ft. after          hours pumping          gpm  
 Est. Yield: 10 gpm: Well water was          ft. after          hours pumping          gpm  
 Bore Hole Diameter: 10 in. to 320 ft., and          in. to          ft.  
 WELL WATER TO BE USED AS:  
 Domestic    3 Feedlot    6 Oil field water supply    9 Dewatering    12 Other (Specify below)  
 2 Irrigation    4 Industrial    7 Lawn and garden only    10 Monitoring well  
 Was a chemical/bacteriological sample submitted to Department? Yes          No XX; If yes, mo/day/yr sample was submitted           
 Water Well Disinfected? Yes XX No         

5 TYPE OF BLANK CASING USED:  
 1 Steel    3 RMP (SR)    5 Wrought iron    8 Concrete tile    CASING JOINTS: Glued XX Clamped           
 PVC    4 ABS    6 Asbestos-Cement    9 Other (specify below)    Welded           
 Blank casing diameter: 5 in. to 280 ft., Dia.          in. to          ft., Dia.          in. to          ft.  
 Casing height above land surface: 20 in., weight 2.8 lbs./ft. Wall thickness or gauge No. 265  
 TYPE OF SCREEN OR PERFORATION MATERIAL:  
 PVC    10 Asbestos-cement  
 1 Steel    3 Stainless steel    5 Fiberglass    8 RMP (SR)    11 Other (specify)           
 2 Brass    4 Galvanized steel    6 Concrete tile    9 ABS    12 None used (open hole)  
 SCREEN OR PERFORATION OPENINGS ARE:  
 1 Continuous slot     Mill slot    5 Gauzed wrapped    8 Saw cut    11 None (open hole)  
 2 Louvered shutter    4 Key punched    6 Wire wrapped    9 Drilled holes  
 7 Torch cut    10 Other (specify)           
 SCREEN-PERFORATED INTERVALS: From 280 ft. to 320 ft., From          ft. to          ft.  
 GRAVEL PACK INTERVALS: From 20 ft. to 320 ft., From          ft. to          ft.

6 GROUT MATERIAL: 1 Neat cement    2 Cement grout     Bentonite    4 Other           
 Grout Intervals: From 0 ft. to 20 ft., From          ft. to          ft., From          ft. to          ft.  
 What is the nearest source of possible contamination: • None  
 1 Septic tank    4 Lateral lines    7 Pit privy    10 Livestock pens    14 Abandoned water well  
 2 Sewer lines    5 Cess pool    8 Sewage lagoon    11 Fuel storage    15 Oil well/Gas well  
 3 Watertight sewer lines    6 Seepage pit    9 Feedyard    12 Fertilizer storage    16 Other (specify below)           
 13 Insecticide storage           
 Direction from well?          How many feet?         

FROM	TO	LITHOLOGIC LOG	FROM	TO	PLUGGING INTERVALS
0	3	Topsoil			
3	6	Clay			
6	16	Caliche			
16	31	Yellow Shale			
31	110	Blue Shale			
110	131	Black Shale			
131	173	Blue Shale			
173	191	Sandstone			
191	280	Blue & Red Shale			
280	325	Sandstone			

7 CONTRACTOR'S OR LANDOWNER'S CERTIFICATION: This water well was (1) constructed, (2) reconstructed, or (3) dug under my jurisdiction and was completed on (mo/day/year) April 22, 1992 and this record is true to the best of my knowledge and belief. Kansas Water Well Contractor's License No. 252 This Water Well Record was completed on (mo/day/year) April 24, 1992 by (signature) [Signature]  
 under the business name of Friesen Windmill & Supply Inc.

INSTRUCTIONS: Use typewriter or ball point pen. PLEASE PRESS FIRMLY and PRINT clearly. Please fill in blanks, underline or circle the correct answers. Send top three copies to Kansas Department of Health and Environment, Bureau of Water, Topeka, Kansas 66620-0001. Telephone: 913-296-5545. Send one to WATER WELL OWNER and retain one for your records.