


1 LOCATION OF WATER WELL: County: HODGEMAN Fraction: SW 1/4 NE 1/4 NE 1/4 Section Number: 12 Township Number: T 21 S Range Number: R 22 E

Distance and direction from nearest town or city street address of well if located within city?
2 EAST 7 1/2 NORTH OF HANSTON

2 WATER WELL OWNER: Mrs. Deanna Bowie
 RR#, St. Address, Box # :
 City, State, ZIP Code : Hanston, Ks. 67849
 Board of Agriculture, Division of Water Resources
 Application Number: HG 024

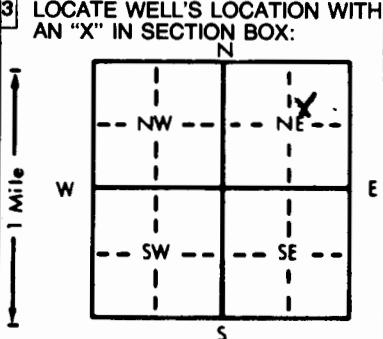

4 DEPTH OF COMPLETED WELL: 107 ft. ELEVATION:
 Depth(s) Groundwater Encountered 1. 53' ft. 2. ft. 3. ft.
 WELL'S STATIC WATER LEVEL 53' 6" ft. below land surface measured on mo/day/yr 6-3-86
 Pump test data: Well water was 70 ft. after 6 hours pumping 900 gpm
 Est. Yield 900 gpm Well water was ft. after hours pumping gpm
 Bore Hole Diameter: 30 in. to 1.07 ft., and in. to ft.
 WELL WATER TO BE USED AS:
 5 Public water supply 8 Air conditioning 11 Injection well
 1 Domestic 3 Feedlot 6 Oil field water supply 9 Dewatering 12 Other (Specify below)
2 Irrigation 4 Industrial 7 Lawn and garden only 10 Observation well
 Was a chemical/bacteriological sample submitted to Department? Yes.....No...X.....; If yes, mo/day/yr sample was submitted
 Water Well Disinfected? Yes X No

5 TYPE OF BLANK CASING USED:
Steel 3 RMP (SR) 5 Wrought iron 8 Concrete tile CASING JOINTS: Welded X Clamped
 2 PVC 4 ABS 6 Asbestos-Cement 9 Other (specify below) Threaded
 7 Fiberglass
 Blank casing diameter 16 in. to 27 ft., Dia in. to ft., Dia in. to ft.
 Casing height above land surface 18 in., weight lbs./ft. Wall thickness or gauge No. 7
 TYPE OF SCREEN OR PERFORATION MATERIAL:
Steel 3 Stainless steel 5 Fiberglass 7 PVC 10 Asbestos-cement
 2 Brass 4 Galvanized steel 6 Concrete tile 8 RMP (SR) 11 Other (specify)
 12 None used (open hole)
 SCREEN OR PERFORATION OPENINGS ARE:
 1 Continuous slot 3 Mill slot 5 Gauzed wrapped 8 Saw cut 11 None (open hole)
 2 Louvered shutter Key punched 6 Wire wrapped 9 Drilled holes
 7 Torch cut 10 Other (specify)
 SCREEN-PERFORATED INTERVALS: From 27 ft. to 107 ft., From ft. to ft.
 From ft. to ft., From ft. to ft.
 GRAVEL PACK INTERVALS: From 10 ft. to 107 ft., From ft. to ft.
 From ft. to ft., From ft. to ft.

6 GROUT MATERIAL: 1 Neat cement Cement grout 3 Bentonite 4 Other
 Grout Intervals: From 0 ft. to 10 ft., From ft. to ft., From ft. to ft.
 What is the nearest source of possible contamination:
 1 Septic tank 4 Lateral lines 7 Pit privy 10 Livestock pens 14 Abandoned water well
 2 Sewer lines 5 Cess pool 8 Sewage lagoon 11 Fuel storage 15 Oil well/Gas well
 3 Watertight sewer lines 6 Seepage pit 9 Feedyard 12 Fertilizer storage 16 Other (specify below)
NONE
 Direction from well? How many feet?

FROM	TO	LITHOLOGIC LOG	FROM	TO	LITHOLOGIC LOG
0	30	topsoil & clay			
30	53	sand			
53	60	clay			
60	79	sand			
79	90	clay			
90	107	sand & rock			

7 CONTRACTOR'S OR LANDOWNER'S CERTIFICATION: This water well was (1) constructed, (2) reconstructed, or (3) plugged under my jurisdiction and was completed on (mo/day/year) 7-30-86 and this record is true to the best of my knowledge and belief. Kansas Water Well Contractor's License No. 130 This Water Well Record was completed on (mo/day/yr) 10-15-88 under the business name of LEO KNOEFLER DRILLING by (signature) Leo Knoefler

INSTRUCTIONS: Use typewriter or ball point pen. PLEASE PRESS FIRMLY and PRINT clearly. Please fill in blanks, underline or circle the correct answers. Send top three copies to Kansas Department of Health and Environment, Office of Oil Field and Environmental Geology, Regulation and Permitting Section, Topeka, Kansas 66620-7500, Telephone: 913-862-9360. Send one to WATER WELL OWNER and retain one for your records.