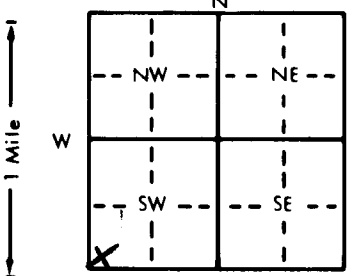


1 LOCATION OF WATER WELL: Fraction SW 1/4 SW 1/4 SW 1/4 Section Number 21 Township Number T 21 S Range Number R 22 EW
 County: HODGEMAN
 Distance and direction from nearest town or city street address of well if located within city? 4 mile North, 2 mile West and 1 mile North of HANSTON, KS. 67849

2 WATER WELL OWNER: GOLDA POWERS
 RR#, St. Address, Box # : 1000 CAMELOT DRIVE Board of Agriculture, Division of Water Resources
 City, State, ZIP Code : HARLINGEN, TX. 78550 Application Number:

3 LOCATE WELL'S LOCATION WITH AN "X" IN SECTION BOX:  4 DEPTH OF COMPLETED WELL 265 ft. ELEVATION: UPLAND
 Depth(s) Groundwater Encountered 1 210 ft. 2. ft. 3. ft.
 WELL'S STATIC WATER LEVEL 151 ft. below land surface measured on mo/day/yr JUNE 1, 1990
 Pump test data: Well water was 155 ft. after 24 hours pumping 12 gpm
 Est. Yield 75 gpm: Well water was ft. after hours pumping gpm
 Bore Hole Diameter 8 in. to 265 ft., and in. to ft.
 WELL WATER TO BE USED AS: 5 Public water supply 8 Air conditioning 11 Injection well
1 Domestic 3 Feedlot 6 Oil field water supply 9 Dewatering 12 Other (Specify below)
 2 Irrigation 4 Industrial 7 Lawn and garden only 10 Monitoring well
 Was a chemical/bacteriological sample submitted to Department? Yes No XX; If yes, mo/day/yr sample was submitted
 Water Well Disinfected? Yes XX No

5 TYPE OF BLANK CASING USED: 5 Wrought iron 8 Concrete tile CASING JOINTS: Glued XX Clamped
 1 Steel 3 RMP (SR) 6 Asbestos-Cement 9 Other (specify below) Welded
2 PVC 4 ABS 7 Fiberglass Threaded
 Blank casing diameter 5 in. to 225 ft., Dia. in. to ft., Dia. in. to ft.
 Casing height above land surface 12 in., weight 2.87 lbs./ft. Wall thickness or gauge No. 265"
 TYPE OF SCREEN OR PERFORATION MATERIAL: 7 PVC 10 Asbestos-cement
 1 Steel 3 Stainless steel 5 Fiberglass 8 RMP (SR) 11 Other (specify)
 2 Brass 4 Galvanized steel 6 Concrete tile 9 ABS 12 None used (open hole)
 SCREEN OR PERFORATION OPENINGS ARE: 5 Gauzed wrapped 8 Saw cut 11 None (open hole)
 1 Continuous slot 3 Mill slot 6 Wire wrapped 9 Drilled holes
 2 Louvered shutter 4 Key punched 7 Torch cut 10 Other (specify)
 SCREEN-PERFORATED INTERVALS: From 225 ft. to 265 ft., From ft. to ft.
 From ft. to ft., From ft. to ft.
 GRAVEL PACK INTERVALS: From 25 ft. to 265 ft., From ft. to ft.
 From ft. to ft., From ft. to ft.

6 GROUT MATERIAL: 1 Neat cement 2 Cement grout 3 Bentonite 4 Other
 Grout Intervals: From 3 ft. to 25 ft., From ft. to ft., From ft. to ft.
 What is the nearest source of possible contamination:
 1 Septic tank 4 Lateral lines 7 Pit privy 10 Livestock pens 14 Abandoned water well
 2 Sewer lines 5 Cess pool 8 Sewage lagoon 11 Fuel storage 15 Oil well/Gas well
 3 Watertight sewer lines 6 Seepage pit 9 Feedyard 12 Fertilizer storage 16 Other (specify below)
 13 Insecticide storage NIL
 Direction from well? How many feet?

| FROM | TO | LITHOLOGIC LOG | FROM | TO | PLUGGING INTERVALS |
|------|-----|-----------------------------|------|----|--------------------|
| 0 | 1.5 | black topsoil | | | |
| 1.5 | 2 | brown clay | | | |
| 2 | 5 | limestone & sand | | | |
| 5 | 9 | sandy brown clay | | | |
| 9 | 21 | limestone & yellow clay | | | |
| 21 | 28 | blue clay | | | |
| 28 | 90 | black shale | | | |
| 90 | 120 | light colored clay | | | |
| 120, | 155 | sticky blue clay | | | |
| 155 | 170 | red clay | | | |
| 170 | 180 | tan clay | | | |
| 180 | 210 | multi-colored shale or clay | | | |
| 210 | 265 | sandstone | | | |
| 265 | 270 | blue clay | | | |

7 CONTRACTOR'S OR LANDOWNER'S CERTIFICATION: This water well was (1) constructed, (2) reconstructed, or (3) plugged under my jurisdiction and was completed on (mo/day/year) JUNE 1, 1990 and this record is true to the best of my knowledge and belief. Kansas Water Well Contractor's License No. 243 This Water Well Record was completed on (mo/day/yr) JUNE 11, 1990 under the business name of DEAN WATERHOUSE DRILLING by (signature) Dean Waterhouse