

JFFMORE NE

T	R	EW	sec 1/4	1/4	1/4	No.
---	---	----	---------	-----	-----	-----

USE TYPEWRITER OR BALL POINT PEN-PRESS FIRMLY, PRINT CLEARLY.


WATER WELL RECORD
KSA 82a-1201-1215

Kansas State Dept. Of Health
(Water Well Contractors)
Forbes-Bldg. 740
Topeka, Kansas 66620

DBA

1 Location of well: County HODGEMAN Township name MARANA Fraction NE NW SE Section number 30 Town number 21 Range number 22

Distance and direction from nearest town or city: 3 MI NORTH
3 MILES WEST OF HANSTON
Street address of well location if in city: _____ Address: HANSTON KANSAS

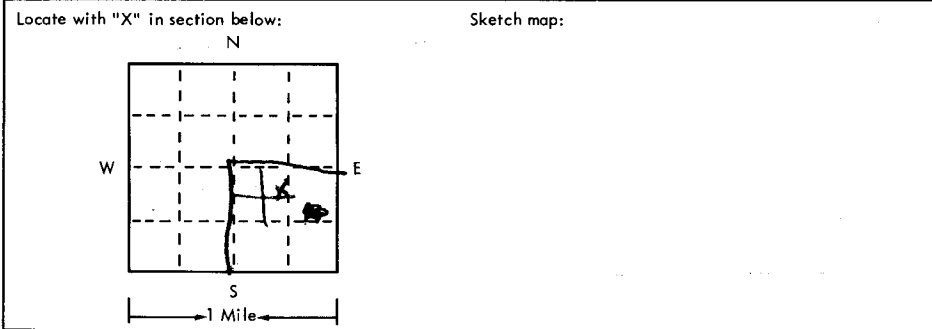

4 Well depth: 38 ft. Date of completion 26-JULY 75
Well diameter 5 in.

5 Cable tool Rotary Driven Dug
 Hollow rod Jetted Bored Reverse rotary

6 Use: Domestic Public supply Industry
 Irrigation Air conditioning Commercial
 Test well _____

7 Casing: Material STEEL Height: above/below
Threaded Welded Surface 26 in.
Diam. _____ Weight 750 lbs./ft.
5 in. to 30 ft. depth Drive shoe? Yes No
_____ in. to _____ ft. depth

2	Type and color of material	From	To
	LIGHT TOPSOIL & CLAY	0	6
	FINE SAND	6	22
	FINE SAND SOME WHITE ROCK	22	28
	YELLOW CLAY	<u>(29)</u>	<u>33</u>
	BLACK SHALE	33	40
	ROCK 29' RR		
	<u>26</u> 3' sand thick		
	in Alluvium		

8 Screen: Manufacturer JESSE + LOWELL
Type STYRENE Dia. 5"
Slot/gauze 4/4 Length 10
Set between 30 ft. and 40 ft. _____
Fittings: Gravel pack Yes No Size range of material 18

9 Static water level: 26 ft. below land surface Date 25-JULY 75

10 Pumping level below land surfaces:
31 ft. after 2 hrs. pumping 2 g.p.m.
_____ ft. after _____ hrs. pumping _____ g.p.m.
Estimated maximum yield 3 g.p.m.

11 Water sample submitted:
 Yes No Date _____

12 Well head completion:
 Pitless adapter 20 inches above grade

13 Well grouted? Yes No
 Neat cement Bentonite _____
Depth: From 0 ft. to 44 ft.

14 Nearest source of possible contamination:
ft. 400 Direction S Type DRAW
Well disinfected upon completion? Yes No

15 Pump: Not installed
Manufacturer's name CLAYTON MARK
Model number _____ HP _____ Volts _____
Length of drop pipe 38 ft. capacity 2 g.p.m.
Type:
 Submersible Turbine
 Jet Reciprocating
 Centrifugal Other

16 Remarks: elevation

Topography: 2271
 Hill 29
 Slope 2242
 Upland TOPO
 Valley

17 Water well contractor's certification:
This well was drilled under my jurisdiction and this report is true to the best of my knowledge and belief.
DEAN WATERHOUSE DRLE
Business name _____ License No. 2413
Address HANSTON KANSAS
Signed Dean Waterhouse Date 25-July 75
Authorized representative