HANSTON NW
KS

USE TYPEWRITER OR BALL POINT PEN-PRESS FIRMLY, PRINT CLEARLY.

WATER WELL RECORD
KSA 82a-1201-1215

ACC

Kansas Department of Health and Environment-Division of Environment
(Water well Contractors)
Topeka, Kansas 66620

1. Location of well:	County: Hodgeman	Fraction: SW 1/4 Sw 1/4 NE 1/4	Section number: 33	Township number: T 21 S	Range number: R 22 E/W

2. Distance and direction from nearest town or city: 4 N, IW of Hanston
Street address of well location if in city:

3. Owner of well: Norbert Burkhart
R.R. or street:
City, state, zip code: Hanston, Kansas 67849

4. Locate with "X" in section below:

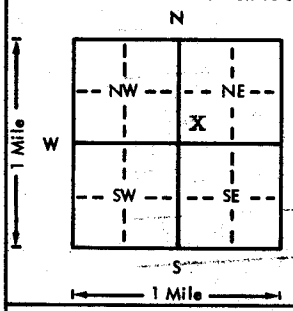

Sketch map:

6. Bore hole dia. 8 in. Completion date 4-15-76
Well depth 50 ft.

7. __ Cable tool X Rotary __ Driven __ Dug
__ Hollow rod __ Jetted __ Bored __ Reverse rotary

8. Use: __ Domestic __ Public supply __ Industry
__ Irrigation __ Air conditioning X Stock
__ Lawn __ Oil field water __ Other

9. Casing: Material pits Height: (Above) or below
Threaded ___ Welded gl Surface 12 in.
RMP X PVC ___ Weight ___ lbs./ft.
Dia. 5 in. to 30 ft. depth Wall Thickness: inches or
Dia. ___ in. to ___ ft. depth gage No. .250

10. Screen: Manufacturer's name Sunflower Plastics Pipe, Inc.
Type REM Dia. 5 in
Slot/gauze 1/8 Length 20ft
Set between 30 ft. and 50 ft.
___ ft. and ___ ft.
Gravel pack? X Size range of material 1/18

11. Static water level: mo./day/yr.
35 ft. below land surface Date 4-15-76

12. Pumping level below land surfaces:
40 ft. after 1 hrs. pumping 10 g.p.m.
___ ft. after ___ hrs. pumping ___ g.p.m.
Estimated maximum yield 15 g.p.m.

13. Water sample submitted: mo./day/yr.
__ Yes X No Date

14. Well head completion:
__ Pitless adapter 12 Inches above grade

15. Well grouted? X
With: __ Neat cement __ Bentonite X Concrete
Depth: From 20 ft. to 0 ft.

16. Nearest source of possible contamination:
ft. 500 Direction SW Type well
Well disinfected upon completion? X Yes __ No

17. Pump: Not installed
Manufacturer's name Aermotor Mill
Model number ___ HP ___ Volts ___
Length of drop pipe 40 ft. capacity 5 g.p.m.
Type:
__ Submersible __ Turbine
__ Jet __ Reciprocating
__ Centrifugal X Other

5. Type and color of material

	From	To
Topsoil	0	4
Clay	4	35
Sand	35	40
Clay	40	42
Sand	42	46
Blue Shale	46	50
BROCK 46' R		
35		
11' set check		
in Alluvium		

(Use a second sheet if needed)

18. Elevation:
Topography:
__ Hill
X Slope
__ Upland
__ Valley

19. Remarks:
Concerete slab was installed
2222
46
TOPO

20. Water well contractor's certification:
This well was drilled under my jurisdiction and this report is true to the best of my knowledge and belief.
Knoefler Bros Drilling
Business name License No.
Address Jetmore, I30
Signed Dale Knoefler Date 5-10-76
Authorized representative

21 22 33 SWSWNE

Forward the white, blue and pink copies to the Department of Health and Environment

Form WWC-5

MI-1023