


WATER WELL RECORD Form WWC-5 KSA 82a-1212

1 LOCATION OF WATER WELL: Fraction Section Number Township Number Range Number  
 COUNTY: HODGEMAN NW 1/4 NW 1/4 SE 1/4 16 T 21 S R 22 W

Distance and direction from nearest town or city street address of well if located within city?  
 JETMORE ON 283 - NORTH 10 N, 8 1/2 EAST & 1/4 NORTH

2 WATER WELL OWNER: WIELAND, CURT  
 RRF, St. Address, Box #: BOX 768 Board of Agriculture, Division of Water Resources  
 City, State, ZIP code: BUFFALO, OK 73834- Application Number:

3 LOCATE WELL'S LOCATION WITH AN "X" IN SECTION BOX: 4 DEPTH OF COMPLETED WELL 425 ELEVATION: 0  
 Depth(s) Groundwater Encountered 1. 0 ft. 2. 0 ft. 3. 0 ft.

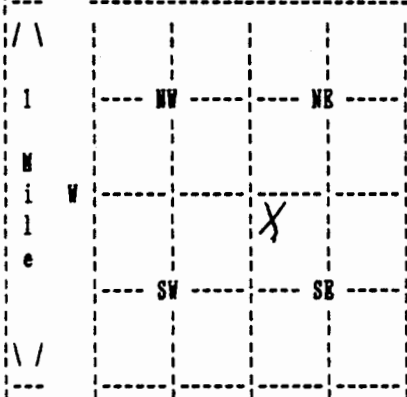

WELL'S STATIC WATER LEVEL 145 ft. below land surface measured on no/day/yr 03/30/06  
 Pump testdata: Well water was 0 ft. after 0 hours pumping 0 gpm  
 Estimated Yield 50 gpm: Well water was 0 ft. after 0 hours pumping 0 gpm  
 Bore Hole Diameter 9 in. to 425 ft., and in. to 0 ft.  
 WELL WATER TO BE USED AS: DOMESTIC

Was a chemical/bacteriological sample submitted to department? No ;  
 If yes, no/day/yr sample was submitted Water well disinfected? Yes

5 TYPE OF BLANK CASING USED: CERTA LOC CASIN CASING JOINTS: CERTA-LOC  
 Blank casing diameter 5 in. to 425 ft., Dia in. to 0 ft., Dia in. to 0 ft.  
 Casing height above land surface 12 in., weight 200 lbs/ft. Wall thickness or gauge No. 21 17  
 TYPE OF SCREEN OR PERFORATION MATERIAL: PVC  
 SCREEN OR PERFORATION OPENINGS ARE: SAW CUT

SCREEN PERFORATED INTERVALS: From 320 ft. to 400 ft., From 0 ft. to 0 ft.  
 From 0 ft. to 0 ft., From 0 ft. to 0 ft.  
 GRAVEL PACK INTERVALS: From 20 ft. to 425 ft., From 0 ft. to 0 ft.  
 From 0 ft. to 0 ft., From 0 ft. to 0 ft.

6 GROUT MATERIAL BENTONITE  
 Grout Intervals: From 0 ft. to 20 ft., From 0 ft. to 0 ft., From 0 ft. to 0 ft.  
 What is the nearest source of possible contamination: ABANDONED WELL  
 Direction from well? EAST How many feet? 10

FROM	TO	LITHOLOGIC LOG	FROM	TO	PLUGGING INTERVALS
0	20	01 TOPSOIL 32 TAN CLAY 21 Limestone			
20	40	21 Limestone 32 TAN CLAY 19 LAYERS			
40	60	32 TAN CLAY 36 BLUE CLAY			
60	120	36 BLUE CLAY 31 SHALE			
120	180	36 BLUE CLAY			
180	240	32 TAN CLAY 26 RED CLAY			
240	300	16 GRAY CLAY			
300	320	16 GRAY CLAY 29 SANDSTONE			
320	380	29 SANDSTONE			
380	425	29 SANDSTONE			

7 CONTRACTOR'S OR LANDOWNER'S CERTIFICATION: This water well was Constructed under my jurisdiction and was completed on (no/day/year) 03/31/06 and this record is true to the best of my knowledge and belief. Kansas Water Well Contractor's License No. 179 This Water Well Record was completed on (no/day/yr) 04/20/06 under the business name of JOB'S WELL SERVICE, INC. by (signature) Judith Crick