


1 LOCATION OF WATER WELL: Fraction nw 1/4 nw 1/4 ne 1/4 Section Number 11 Township Number T 21 S Range Number R 22 **EW**
 County: Hodgeman
 Distance and direction from nearest town or city street address of well if located within city?
8 1/2 miles north of Hanston, Ks. (8 1/2 miles east)

2 WATER WELL OWNER: Jim Cure
 RR#, St. Address, Box #: Hanston, Ks. 67849 Board of Agriculture, Division of Water Resources
 City, State, ZIP Code: Hanston, Ks. 67849 Application Number: 313

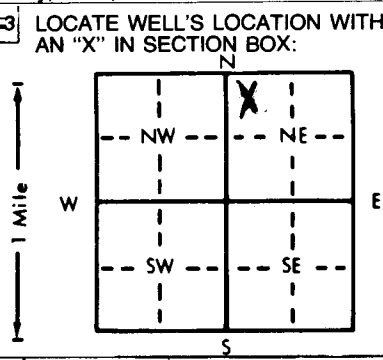

4 DEPTH OF COMPLETED WELL: 9.7 ft. ELEVATION: 12-23-86
 Depth(s) Groundwater Encountered 1. 5.9 ft. 2. 7.4 ft. 3. 8.2 ft.
 WELL'S STATIC WATER LEVEL 5.9 ft. below land surface measured on mo/day/yr 12-23-86
 Pump test data: Well water was xxx 7.4 ft. after 2 hours pumping 250 gpm
 Est. Yield 350 gpm: Well water was xxx 8.2 ft. after 4 hours pumping 350 gpm
 Bore Hole Diameter 2.9 in. to 9.7 ft., and in. to ft.
 WELL WATER TO BE USED AS:
 5 Public water supply 8 Air conditioning 11 Injection well
 1 Domestic 3 Feedlot 6 Oil field water supply 9 Dewatering 12 Other (Specify below)
2 Irrigation 4 Industrial 7 Lawn and garden only 10 Observation well
 Was a chemical/bacteriological sample submitted to Department? Yes No xxx; If yes, mo/day/yr sample was submitted
 Water Well Disinfected? Yes hth No

5 TYPE OF BLANK CASING USED:
 1 Steel 3 RMP (SR) 5 Wrought iron 8 Concrete tile CASING JOINTS: Glued Clamped xxx
2 PVC 4 ABS 6 Asbestos-Cement 9 Other (specify below) Welded
 7 Fiberglass Threaded
 Blank casing diameter 1.6 in. to 7.2 ft., Dia in. to ft., Dia in. to ft.
 Casing height above land surface 1.2 in., weight lbs./ft. Wall thickness or gauge No. 500
 TYPE OF SCREEN OR PERFORATION MATERIAL:
 1 Steel 3 Stainless steel 5 Fiberglass 7 PVC 10 Asbestos-cement
 2 Brass 4 Galvanized steel 6 Concrete tile 8 RMP (SR) 11 Other (specify)
 9 ABS 12 None used (open hole)
 SCREEN OR PERFORATION OPENINGS ARE:
 1 Continuous slot 3 Mill slot 5 Gauzed wrapped 8 Saw cut 11 None (open hole)
 2 Louvered shutter 4 Key punched 6 Wire wrapped 9 Drilled holes
 7 Torch cut 10 Other (specify)
 SCREEN-PERFORATED INTERVALS: From 7.2 ft. to 9.7 ft., From ft. to ft.
 From ft. to ft., From ft. to ft.
 GRAVEL PACK INTERVALS: From 1.0 ft. to 9.7 ft., From ft. to ft.
 From ft. to ft., From ft. to ft.

6 GROUT MATERIAL: 1 Neat cement 2 Cement grout 3 Bentonite 4 Other
 Grout Intervals: From 0 ft. to 1.0 ft., From ft. to ft., From ft. to ft.
 What is the nearest source of possible contamination:
 1 Septic tank 4 Lateral lines 7 Pit privy 10 Livestock pens 14 Abandoned water well
 2 Sewer lines 5 Cess pool 8 Sewage lagoon 11 Fuel storage 15 Oil well/Gas well
 3 Watertight sewer lines 6 Seepage pit 9 Feedyard 12 Fertilizer storage 16 Other (specify below)
 13 Insecticide storage none

Direction from well? How many feet?

FROM	TO	LITHOLOGIC LOG	FROM	TO	LITHOLOGIC LOG
0	2	Top soil			
2	33	Brown clay			
33	33 1/2	Sand			
33 1/2	44	Brown clay			
44	52	Sand and gravel loose			
52	57	Brown clay			
57	81	Sand and gravel loose			
81	91	Yellow clay			
91	93 1/2	Sand and gravel loose			
93 1/2	99	Yellow and white clay			
99	100	Fire clay			

7 CONTRACTOR'S OR LANDOWNER'S CERTIFICATION: This water well was (1) constructed, (2) reconstructed, or (3) plugged under my jurisdiction and was completed on (mo/day/year) 3-13-87 and this record is true to the best of my knowledge and belief. Kansas Water Well Contractor's License No. 134 This Water Well Record was completed on (mo/day/yr) 5-27-87 under the business name of Rosencrantz-Bemis by (signature) Frank Rodson

INSTRUCTIONS: Use typewriter or ball point pen, PLEASE PRESS FIRMLY and PRINT clearly. Please fill in blanks, underline or circle the correct answers. Send top three copies to Kansas Department of Health and Environment, Division of Environment, Environmental Geology Section, Topeka, KS 66620. Send one to WATER WELL OWNER and retain one for your records.

OFFICE USE ONLY

T

R

EW

SEC.

1/4

1/4

1/4