WATER WELL PLUGGING RECORD Form WWC-5P KSA 82a-1212 ID NO. HG-22

1 LOCATION OF WATER WELL: County: Hodgeman | Fraction: NE¼ NW¼ NW¼ | Section Number: 12 | Township Number: 21 | Range Number: 22 E/W

Distance and direction from nearest town or city street address of well if located within city?

8½ North, 3/4 East of Hanston

2 WATER WELL OWNER: Vyrl McFadden
RR#, St. Address, Box #: 332 N. Oakwood Ct
City, State ZIP Code: Wichita, Ks. 67208

Global Positioning Systems (decimal degrees, min. of 4 digits
Latitude:
Longitude:
Elevation:
Datum:
Data Collection Method:

3 MARK WELL'S LOCATION WITH AN "X" IN SECTION BOX:

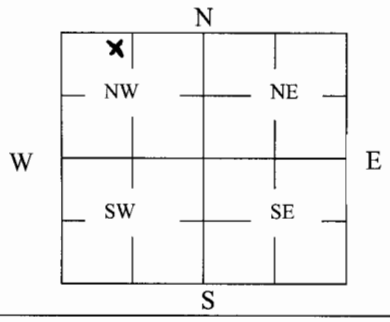

4 DEPTH OF WELL 103 ft.

WELL'S STATIC WATER LEVEL 40 ft

WELL WAS USED AS:

1 Domestic 5 Public Water Supply 9 Dewatering
2 Irrigation 6 Oil Field Water Supply 10 Monitoring
3 Feedlot 7 Domestic (Lawn & Garden) 11 Injection Well
4 Industrial 8 Air Conditioning 12 Other

Was a chemical/bacteriological sample submitted to Department? Yes ____ No X

5 TYPE OF BLANK CASING USED:

1 Steel 3 RMP (SR) 5 Wrought 7 Fiberglass 9 Other (Specify below)
2 PVC 4 ABS 6 Asbestos-Cement 8 Concrete Tile

Blank casing diameter 16 in. Was casing pulled? Yes ____ No X If yes, how much
Casing height above or below land surface 36 in.

6 GROUT PLUG MATERIAL: 1 Neat cement 2 Cement grout 3 Bentonite 4 Other

Grout Plug Intervals: From 40 ft. to 3 ft., From ____ ft. to ____ ft., From ____ to ____ ft.

What is the nearest source of possible contamination:

1 Septic tank 6 Seepage pit 11 Fuel Storage 16 Other (specify below)
2 Sewer lines 7 Pit privy 12 Fertilizer storage None
3 Watertight sewer lines 8 Sewage lagoon 13 Insecticide storage
4 Lateral lines 9 Feedyard 14 Abandoned water well Direction from well?
5 Cess pool 10 Livestock pens 15 Oil well/Gas well How many feet?

FROM	TO	PLUGGING MATERIALS	FROM	TO	PLUGGING MATERIALS
103	40	Chlorinated gravel			
40	3	Cement			
3	0	Top soil			

7 CONTRACTOR'S OR LANDOWNER'S CERTIFICATION: This water well was plugged under my jurisdiction and was completed on (mo/day/year) 9-1-09 and this record is true to the best of my knowledge and belief. Kansas Water Well Contractor's License No. 134. This Water Well Record was completed on (mo/day/year) 9-28-09 under the business name of Rosencrantz- Bemis by (signature) Tom Abel

INSTRUCTIONS: Use typewriter or ballpoint pen. Please press firmly and print clearly. Please fill in blanks, underline or circle the correct answers. Send top three copies to Kansas Department of Health and Environment, Bureau of Water, Geology Section, 1000 SW Jackson St., Ste. 420, Topeka, Kansas 66612-1367. Telephone: 785/296-5522. Send one to Water Well Owner and retain one for your records. Visit us at http://www.kdheks.gov/geo/waterwells.