

County: Hodgeman Fraction NW SE SW NW Sec. 14 T 21 S R 22 E (W)

CORRECTION(S) TO WATER WELL COMPLETION RECORD (WWC-5)

(to rectify lacking or incorrect information)

Owner: Deanna Schlereth

Location was listed as:

Section-Township-Range: None Given

Fraction (1/4 1/4 1/4): _____

Location changed to:

14-21S-22W

NW SE SW NW

Other changes: Initial statements: Owner's last name illegible.

County: HG

Changed to: Schlereth

County: Hodgeman

Comments: _____

Verification method: Latitude & longitude, KGS' "LEO" conversion tool,
information on Hodgeman County online parcel search, and mapping
tool & aerial photos on KGS website. initials: DRL date: 3/10/2016

Submitted by: Kansas Geological Survey, Data Resources Library, 1930 Constant Ave., Lawrence, KS 66047-3726

to: Kansas Dept of Health & Environment, Bureau of Water, 1000 SW Jackson, Suite 420, Topeka, KS 66612-1367.

WATER WELL RECORD

Form WWC-5


Division of Water Resources App. No.

1 LOCATION OF WATER WELL: County: <u>HG</u>	Fraction $\frac{1}{4}$ $\frac{1}{4}$ $\frac{1}{4}$ $\frac{1}{4}$	Section Number	Township No. T S	Range Number R <input type="checkbox"/> E <input type="checkbox"/> W
---	---	----------------	-----------------------	---

Street/Rural Address of Well Location; if unknown, distance & direction from nearest town or intersection: If at owner's address, check here .
8 miles North of Hanston on 228 Rd + W Rd
1/4 mile in on the east side of 228 Rd

Global Positioning System (GPS) information:
 Latitude: 38.8270309 (in decimal degrees)
 Longitude: -99.7140715 (in decimal degrees)
 Elevation: 2203
 Datum: WGS 84, NAD 83, NAD 27
 Collection Method:
 GPS unit (Make/Model: CPSTest)
 Digital Map/Photo, Topographic Map, Land Survey
 Est. Accuracy: <3 m, 3-5 m, 5-15 m, >15 m

2 WATER WELL OWNER: Dennis Schlyth
 RR#, Street Address, Box #: 2300 Robin Rd
 City, State, ZIP Code Dodge City, KS 67801

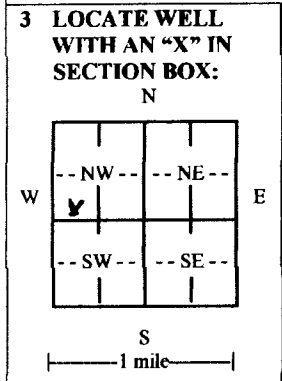

4 DEPTH OF COMPLETED WELL 300 ft.

Depth(s) Groundwater Encountered (1) _____ ft. (2) _____ ft. (3) _____ ft.
 WELL'S STATIC WATER LEVEL 160 ft. below land surface measured on mo/day/yr _____

Pump test data: Well water was _____ ft. after _____ hours pumping _____ gpm
 EST. YIELD 15 gpm. Well water was _____ ft. after _____ hours pumping _____ gpm
 Bore Hole Diameter 9.25 in. to _____ ft., and _____ in. to _____ ft.

WELL WATER TO BE USED AS: Public water supply Geothermal Injection well
 Domestic Feedlot Oil field water supply Dewatering Other (Specify below) _____
 Irrigation Industrial Domestic-lawn & garden Monitoring well _____

Was a chemical/bacteriological sample submitted to Department? Yes No
 If yes, mo/day/yr sample was submitted _____
 Water well disinfected? Yes No

5 TYPE OF CASING USED: Steel PVC Other _____

CASING JOINTS: Glued Clamped Welded Threaded

Casing diameter 5 in. to 29.5 ft., Diameter _____ in. to _____ ft., Diameter _____ in. to _____ ft.
 Casing height above land surface 24 in., Weight _____ lbs./ft., Wall thickness or gauge No. SDR 21

TYPE OF SCREEN OR PERFORATION MATERIAL:
 Steel Stainless Steel PVC Other (Specify) _____
 Brass Galvanized Steel None used (open hole)

SCREEN OR PERFORATION OPENINGS ARE:
 Continuous slot Mill slot Gauze wrapped Torch cut Drilled holes None (open hole)
 Louvered shutter Key punched Wire wrapped Saw cut Other (specify) _____

SCREEN-PERFORATED INTERVALS: From 200 ft. to 300 ft., From _____ ft. to _____ ft.
 From _____ ft. to _____ ft., From _____ ft. to _____ ft.

GRAVEL PACK INTERVALS: From 260 ft. to 300 ft., From _____ ft. to _____ ft.
 From _____ ft. to _____ ft., From _____ ft. to _____ ft.

6 GROUT MATERIAL: Neat cement Cement grout Bentonite Other _____

Grout Intervals: From _____ ft. to 25 ft., From _____ ft. to _____ ft., From _____ ft. to _____ ft.

What is the nearest source of possible contamination:
 Septic tank Lateral lines Pit privy Livestock pens Insecticide storage Other (specify below) _____
 Sewer lines Cesspool Sewage lagoon Fuel storage Abandoned water well
 Watertight sewer lines Seepage pit Feedyard Fertilizer storage Oil well/gas well _____

Direction from well South E.S.L. Distance from well 50 yards

FROM	TO	LITHOLOGIC LOG	FROM	TO	LITHO. LOG (cont.) or PLUGGING INTERVALS
0	20	Topsoil tan clay			
20	40	Tan clay rock layers			
40	120	Blue clay/shale			
120	140	White clay			
140	180	Red clay			
180	220	Red clay sandstone layers			
220	260	shale sandstone layers			
260	300	Sand stone			

7 CONTRACTOR'S OR LANDOWNER'S CERTIFICATION: This water well was constructed, reconstructed, or plugged under my jurisdiction and was completed on (mo/day/year) 3/19/15 and this record is true to the best of my knowledge and belief.
 Kansas Water Well Contractor's License No. 883 This Water Well Record was completed on (mo/day/year) 3/21/15
 under the business name of Halling Water Well by (signature) [Signature]

INSTRUCTIONS: Use typewriter or ball point pen. PLEASE PRESS FIRMLY and PRINT clearly. Please fill in blanks and check the correct answers. Send one copy to Kansas Department of Health and Environment, Bureau of Water, Geology Section, 1000 SW Jackson St., Suite 420, Topeka, Kansas 66612-1367. Telephone 785-296-5524. Send one copy to WATER WELL OWNER and retain one for your records. Include fee of \$5.00 for each constructed well. Visit us at