


WATER WELL RECORD Form WWC-5 KSA 82a-1212

LOCATION OF WATER WELL: Fraction Section Number Township Number Range Number
 COUNTY: HODGEMAN 1/4 1/4 1/4 3 T 21 S R 23 W

Distance and direction from nearest town or city street address of well if located within city?
 FROM JETMORE - 2 NORTH ON HIGHWAY 283 - 3 E & 1/4 NORTH

WATER WELL OWNER: FRUSHER, LARRY
 RR#, St. Address, Box #: RR 2 -- BOX 252 Board of Agriculture, Division of Water Resources
 City, State, ZIP code: JETMORE, KS 67854- Application Number:

LOCATE WELL'S LOCATION WITH AN "X" IN SECTION BOX: 4 DEPTH OF COMPLETED WELL 485 ELEVATION: 0
 Depth(s) Groundwater Encountered 1. 0 ft. 2. 0 ft. 3. 0 ft.

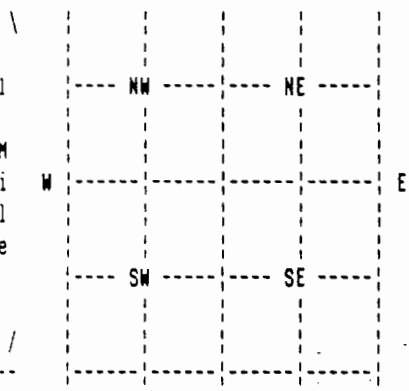

WELL'S STATIC WATER LEVEL 120 ft. below land surface measured on mo/day/yr 04/27/99
 Pump test data: Well water was 0 ft. after 0 hours pumping 0 gpm
 Estimated Yield 60 gpm: Well water was 0 ft. after 0 hours pumping 0 gpm
 Bore Hole Diameter 9 in. to 485 ft., and in. to 0 ft.
 WELL WATER TO BE USED AS: DOMESTIC
 Was a chemical/bacteriological sample submitted to department? No ;
 If yes, mo/day/yr sample was submitted Water well disinfected? Yes

TYPE OF BLANK CASING USED: PVC CASING JOINTS: GLUED
 Blank casing diameter 5 in. to 485 ft., Dia in. to 0 ft., Dia in. to 0 ft.
 Casing height above land surface 12 in., weight 200 lbs/ft. Wall thickness or gauge No. 21 17
 TYPE OF SCREEN OR PERFORATION MATERIAL: PVC
 SCREEN OR PERFORATION OPENINGS ARE: SAW CUT

SCREEN PERFORATED INTERVALS: From 320 ft. to 360 ft., From 0 ft. to 0 ft.
 From 420 ft. to 480 ft., From 0 ft. to 0 ft.
 GRAVEL PACK INTERVALS: From 20 ft. to 40 ft., From 0 ft. to 0 ft.
 From 65 ft. to 485 ft., From 0 ft. to 0 ft.

GROUT MATERIAL BENTONITE
 Grout Intervals: From 6 ft. to 20 ft., From 40 ft. to 65 ft., From 0 ft. to 0 ft.
 What is the nearest source of possible contamination: ABANDONED WELL
 Direction from well? SOUTH How many feet? 22

FROM	TO	LITHOLOGIC LOG	FROM	TO	PLUGGING INTERVALS
0	15	01 TOPSOIL 05 CLAY			
15	28	10 FINE-MEDSAND 04 COARSE SAND			
28	40	05 CLAY 24 THINROCLAYER 07 BLUE SHALE			
40	140	07 BLUE SHALE 24 THINROCLAYER			
140	180	36 BLUE CLAY			
180	210	16 GRAY CLAY			
210	240	29 SANDSTONE 16 GRAY CLAY 20 IN LAYERS			
240	260	16 GRAY CLAY 13 RED BED 29 SANDSTONE			
260	360	29 SANDSTONE			
360	410	16 GRAY CLAY 29 SANDSTONE 20 IN LAYERS			

7 CONTRACTOR'S OR LANDOWNER'S CERTIFICATION: This water well was Constructed under my jurisdiction and was completed on (mo/day/year) 04/28/99 and this record is true to the best of my knowledge and belief. Kansas Water Well Contractor's License No. 179 This Water Well Record was completed on (mo/day/yr) 05/20/99 under the business name of JOE'S WELL SERVICE, INC. by (signature) *David Crist*

FROM	TO	LITHOLOGIC LOG
410	490	29 SANDSTONE