


WATER WELL RECORD Form WWC-5 KSA 82a-1212

1 LOCATION OF WATER WELL: Fraction Section Number Township Number Range Number
 COUNTY: HODGEMAN SE 1/4 SW 1/4 SE 1/4 16 T 21 S R 23 W

Distance and direction from nearest town or city street address of well if located within city?
 FROM JETMORE - 9 N ON 283, 2 3/4 E ON Y ROAD

2 WATER WELL OWNER: BROWN, ERIC
 RR#, St. Address, Box #: 30724 NE V ROAD Board of Agriculture, Division of Water Resources
 City, State, ZIP code: JETMORE, KS 67854- Application Number:

3 LOCATE WELL'S LOCATION WITH AN "X" IN SECTION BOX:

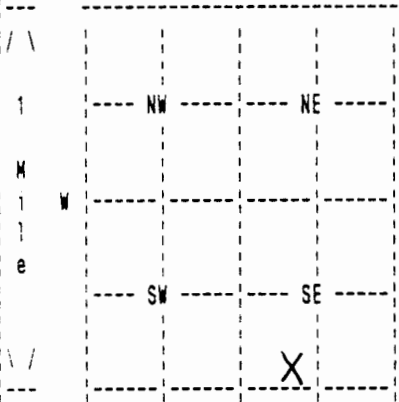

4 DEPTH OF-COMPLETED WELL 65 ELEVATION: 0
 Depth(s) Groundwater Encountered 1. 0 ft. 2. 0 ft. 3. 0 ft.

WELL'S STATIC WATER LEVEL 32 ft. below land surface measured on mo/day/yr 08/16/07
 Pump test data: Well water was 0 ft. after 0 hours pumping 0 gpm

Estimated Yield 25 gpm: Well water was 0 ft. after 0 hours pumping 0 gpm

Bore Hole Diameter 10 in. to 65 ft., and in. to 0 ft.

WELL WATER TO BE USED AS: DOMESTIC

Was a chemical/bacteriological sample submitted to department? No ;
 If yes, mo/day/yr sample was submitted Water well disinfected? Yes

5 TYPE OF BLANK CASING USED: CERTA LOC CASIN CASING JOINTS: CERTA-LOC
 Blank casing diameter 5 in. to 65 ft., Dia in. to 0 ft., Dia in. to 0 ft.
 Casing height above land surface 12 in., weight 200 lbs/ft. Wall thickness or gauge No. 21
 TYPE OF SCREEN OR PERFORATION MATERIAL: PVC
 SCREEN OR PERFORATION OPENINGS ARE: SAW CUT

SCREEN PERFORATED INTERVALS: From 40 ft. to 60 ft., From 0 ft. to 0 ft.
 From 0 ft. to 0 ft., From 0 ft. to 0 ft.
 GRAVEL PACK INTERVALS: From 28 ft. to 65 ft., From 0 ft. to 0 ft.
 From 0 ft. to 0 ft., From 0 ft. to 0 ft.

6 GROUT MATERIAL BENTONITE
 Grout Intervals: From 6 ft. to 28 ft., From 0 ft. to 0 ft., From 0 ft. to 0 ft.
 What is the nearest source of possible contamination: ABANDONED WELL
 Direction from well? SOUTH How many feet? 60

FROM	TO	LITHOLOGIC LOG	FROM	TO	PLUGGING INTERVALS
0	20	01 TOPSOIL 05 CLAY 10 FINE-MEDSAND			
20	40	37 FIN-COAR SAN 38 SMAL-MED GRA			
40	50	37 FIN-COAR SAN			
50	65	24 THINROCLAYER 07 BLUE SHALE			

7 CONTRACTOR'S OR LANDOWNER'S CERTIFICATION: This water well was Constructed under my jurisdiction and was completed on (mo/day/year) 08/16/07 and this record is true to the best of my knowledge and belief. Kansas Water Well Contractor's License No. 179 This Water Well Record was completed on (mo/day/yr) 08/22/07 under the business name of JOE'S WELL SERVICE, INC. by (signature) *Judith Crick*