


WATER WELL RECORD Form WWC-5 KSA 82a-1212

1 LOCATION OF WATER WELL: Fraction NW 1/4 NE 1/4 NE 1/4 Section Number 32 Township Number T 21 S Range Number R 25 W
 COUNTY: HODGEMAN

Distance and direction from nearest town or city street address of well if located within city?
 FROM JETMORE - JCT. 156 & 282 - 10 W, 8 N AND 1/4 WEST

2 WATER WELL OWNER: KYLE, KAREN
 RR#, St. Address, Box #: BOX 397 Board of Agriculture, Division of Water Resources
 City, State, ZIP code: JETMORE, KS 67854-0397 Application Number:

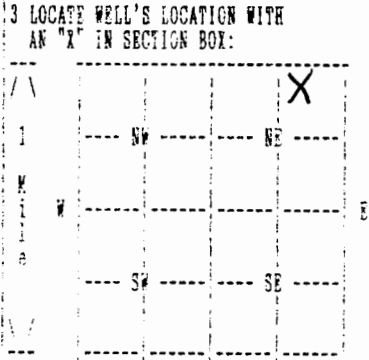

4 DEPTH OF COMPLETED WELL 63 ELEVATION: 0
 Depth(s) Groundwater Encountered 1. 0 ft. 2. 0 ft. 3. 0 ft.
 WELL'S STATIC WATER LEVEL 51 ft. below land surface measured on mo/day/yr 05/30/96
 Pump test data: Well water was 0 ft. after 0 hours pumping 0 gpm
 Estimated Yield 10 gpm; Well water was 0 ft. after 0 hours pumping 0 gpm
 Bore Hole Diameter 10 in. to 63 ft. and in. to 0 ft.
 WELL WATER TO BE USED AS: DOMESTIC
 Was a chemical/bacteriological sample submitted to department? No
 If yes, mo/day/yr sample was submitted Water well disinfected? Yes

5 TYPE OF BLANK CASING USED: PVC CASING JOINTS: GLUED
 Blank casing diameter 5 in. to 63 ft., Dia in. to 0 ft., Dia in. to 0 ft.
 Casing height above land surface 12 in., weight 200 lbs/ft. Wall thickness or gauge No. 21
 TYPE OF SCREEN OR PERFORATION MATERIAL: PVC
 SCREEN OR PERFORATION OPENINGS ARE: SAW CUT

SCREEN PERFORATED INTERVALS: From 40 ft. to 60 ft., From 0 ft. to 0 ft.
 From 0 ft. to 0 ft., From 0 ft. to 0 ft.
 GRAVEL PACK INTERVALS: From 25 ft. to 63 ft., From 0 ft. to 0 ft.
 From 0 ft. to 0 ft., From 0 ft. to 0 ft.

6 GROUT MATERIAL BENTONITE
 Grout intervals: From 0 ft. to 25 ft., From 0 ft. to 0 ft., From 0 ft. to 0 ft.
 What is the nearest source of possible contamination: NONE - NEW SITE
 Direction from well? How many feet? 0

FROM	TO	LITHOLOGIC LOG	FROM	TO	PLUGGING INTERVALS
0	10	TOPSOIL CLAY			
10	35	FINE - MED SAND			
35	42	CLAY			
42	45	THIN ROCK LAYER FINE - MED SAND			
45	56	MED-COARSE SAND ROCK			
56	71	CLAY			
71	80	BLUE SHALE			

7 CONTRACTOR'S OR LANDOWNER'S CERTIFICATION: This water well was constructed under my jurisdiction and was completed on (mo/day/year) 05/30/96 and this record is true to the best of my knowledge and belief. Kansas Water Well Contractor's License No. 179 This Water Well Record was completed on (mo/day/yr) 06/07/96 under the business name of JOE'S WELL SERVICE, INC. by (signature) *Judith Creek*