


1 LOCATION OF WATER WELL: Fraction **NW 1/4 SW 1/4 SW 1/4** Section Number **11** Township Number **T 21 S** Range Number **R 25 EW**
 County: **HODGEMAN**

Distance and direction from nearest town or city street address of well if located within city? **11 mile NORTH and 8 mile WEST of JETMORE, KS. 67854**

2 WATER WELL OWNER: **J.D. NUSS**
 RR#, St. Address, Box # : _____ Board of Agriculture, Division of Water Resources
 City, State, ZIP Code : **JETMORE, KS. 67854** Application Number: _____

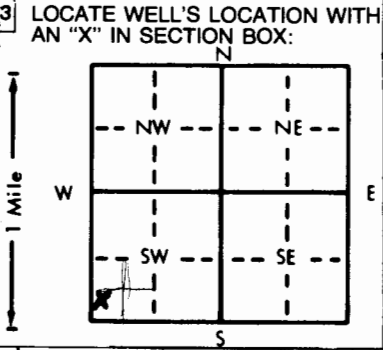

4 DEPTH OF COMPLETED WELL **58** ft. ELEVATION: **VALLEY**
 Depth(s) Groundwater Encountered # 1 **35** ft. 2 **45** ft. 3 _____ ft.
 WELL'S STATIC WATER LEVEL **32** ft. below land surface measured on mo/day/yr **JULY 19, 1985**
 Pump test data: Well water was **34** ft. after **4** hours pumping **12** gpm
 Est. Yield **50** gpm: Well water was _____ ft. after _____ hours pumping _____ gpm
 Bore Hole Diameter **8** in. to **58** ft., and _____ in. to _____ ft.
 WELL WATER TO BE USED AS: 5 Public water supply 8 Air conditioning 11 Injection well
1 Domestic 3 Feedlot 6 Oil field water supply 9 Dewatering 12 Other (Specify below)
 2 Irrigation 4 Industrial 7 Lawn and garden only 10 Observation well
 Was a chemical/bacteriological sample submitted to Department? Yes _____ No **XX**; If yes, mo/day/yr sample was submitted _____
 Water Well Disinfected? Yes **XX** No _____

5 TYPE OF BLANK CASING USED: 5 Wrought iron 8 Concrete tile CASING JOINTS: Glued **XX** Clamped _____
 1 Steel 3 RMP (SR) 6 Asbestos-Cement 9 Other (specify below) Welded _____
2 PVC 4 ABS 7 Fiberglass _____ Threaded _____
 Blank casing diameter **5** in. to **38** ft., Dia _____ in. to _____ ft., Dia _____ in. to _____ ft.
 Casing height above land surface **12** in., weight _____ lbs./ft. Wall thickness or gauge No. **200 PLUS**
 TYPE OF SCREEN OR PERFORATION MATERIAL: 7 PVC 10 Asbestos-cement
 1 Steel 3 Stainless steel 5 Fiberglass 8 RMP (SR) 11 Other (specify) _____
 2 Brass 4 Galvanized steel 6 Concrete tile 9 ABS 12 None used (open hole)
 SCREEN OR PERFORATION OPENINGS ARE: 5 Gauzed wrapped 8 Saw cut 11 None (open hole)
 1 Continuous slot 3 Mill slot 6 Wire wrapped 9 Drilled holes
 2 Louvered shutter 4 Key punched 7 Torch cut 10 Other (specify) _____
 SCREEN-PERFORATED INTERVALS: From **38** ft. to **58** ft., From _____ ft. to _____ ft.
 From _____ ft. to _____ ft., From _____ ft. to _____ ft.
 GRAVEL PACK INTERVALS: From **15** ft. to **58** ft., From _____ ft. to _____ ft.
 From _____ ft. to _____ ft., From _____ ft. to _____ ft.

6 GROUT MATERIAL: **1 Neat cement** 2 Cement grout 3 Bentonite 4 Other _____
 Grout Intervals: From **3** ft. to **15** ft., From _____ ft. to _____ ft., From _____ ft. to _____ ft.
 What is the nearest source of possible contamination: **10 Livestock pens** 14 Abandoned water well
 1 Septic tank 4 Lateral lines 7 Pit privy 11 Fuel storage 15 Oil well/Gas well
 2 Sewer lines 5 Cess pool 8 Sewage lagoon 12 Fertilizer storage 16 Other (specify below)
 3 Watertight sewer lines 6 Seepage pit 9 Feedyard 13 Insecticide storage
 Direction from well? **NORTHEAST** How many feet? **200**

FROM	TO	LITHOLOGIC LOG	FROM	TO	LITHOLOGIC LOG
0	4	black topsoil			
4	15	tan clay			
15	19	sand			
19	35	brown clay			
35	38	sand			
38	40	black clay			
40	45	blue clay			
45	56	blue sand			
56	60	black shale			

7 CONTRACTOR'S OR LANDOWNER'S CERTIFICATION: This water well was (1) constructed, (2) reconstructed, or (3) plugged under my jurisdiction and was completed on (mo/day/year) **JULY 19, 1985** and this record is true to the best of my knowledge and belief. Kansas Water Well Contractor's License No. **243** This Water Well Record was completed on (mo/day/yr) **JULY 29, 1985** under the business name of **DEAN WATERHOUSE DRILLING** by (signature) *Dean Waterhouse*

INSTRUCTIONS: Use typewriter or ball point pen, PLEASE PRESS FIRMLY and PRINT clearly. Please fill in blanks, underline or circle the correct answers. Send top three copies to Kansas Department of Health and Environment, Division of Environment, Environmental Geology Section, Topeka, KS 66620. Send one to WATER WELL OWNER and retain one for your records.