

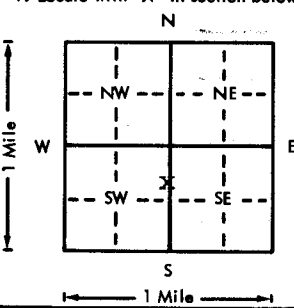
HORSE THIEF CANYON NE

USE TYPEWRITER OR BALL POINT PEN-PRESS FIRMLY, PRINT CLEARLY.

CAID

WATER WELL RECORD
KSA 820-1201-1215

Kansas Department of Health and Environment-Division of Environment
(Water well Contractors)
Topeka, Kansas 66620

1. Location of well: County: Hodgeman		Fraction: SE 1/4 NE 1/4 SW 1/4		Section number: 32		Township number: T 21 S R 25 E 1/4		Range number: 25	
2. Distance and direction from nearest town or city: Street address of well location if in city: 10 mi west and 7 1/2 north of Jetmore				3. Owner of well: Bill Cohoon R.R. or street: City, state, zip code: Jetmore, Kansas					
4. Locate with "X" in section below: Sketch map: 				6. Bore hole dia. 26 in. Completion date _____ Well depth 503 ft. 5-4-76					
5. Type and color of material				From		To		7. Cable tool <input type="checkbox"/> Rotary <input type="checkbox"/> Driven <input type="checkbox"/> Dug <input type="checkbox"/> Hollow rod <input type="checkbox"/> Jetted <input type="checkbox"/> Bored <input checked="" type="checkbox"/> Reverse rotary	
Sandy brown clay				0		17		8. Use: <input type="checkbox"/> Domestic <input type="checkbox"/> Public supply <input type="checkbox"/> Industry <input checked="" type="checkbox"/> Irrigation <input type="checkbox"/> Air conditioning <input type="checkbox"/> Stock <input type="checkbox"/> Lawn <input type="checkbox"/> Oil field water <input type="checkbox"/> Other	
Med. sand & gravel-dry				17		45		9. Casing: Material Metal Height: Above or below Threaded <input type="checkbox"/> Welded <input checked="" type="checkbox"/> Surface 12 in. RMP <input type="checkbox"/> PVC <input type="checkbox"/> Weight 36.87 lbs./ft. Dia 16 in. to 503 ft. depth Wall Thickness: inches or Dia. _____ in. to _____ ft. depth gage No. 219	
Clay & fine sand				45		60		10. Screen: Manufacturer's name _____ A. Brown Type 10% free-flow Dia. 16 Slot/gauze 1/8 Length 160 Set between 381 ft. and 501 ft. ft. and _____ ft. Gravel pack? <input checked="" type="checkbox"/> Yes Size range of material 3/8 CMA	
Yellow caleche clay				60		75		11. Static water level: _____ mo./day/yr. 281 ft. below land surface Date 4-9-76	
Gray, blue & black shale with rock layers				75		267		12. Pumping level below land surfaces: 363 ft. after 24 hrs. pumping 700 g.p.m. _____ ft. after _____ hrs. pumping _____ g.p.m. Estimated maximum yield 1500 g.p.m.	
Light gray shale with 5% sandstone				267		271		13. Water sample submitted: _____ mo./day/yr. <input type="checkbox"/> Yes <input checked="" type="checkbox"/> No Date _____	
Light gray shale with hard rock layers				271		350		14. Well head completion: <input type="checkbox"/> Pitless adapter <input checked="" type="checkbox"/> _____ Inches above grade	
Light gray shale with 5% sandstone				350		358		15. Well grouted? <input checked="" type="checkbox"/> Yes With: <input type="checkbox"/> Neat cement <input type="checkbox"/> Bentonite <input checked="" type="checkbox"/> Concrete Depth: From 0 ft. to 10 ft.	
Light gray shale				358		368		16. Nearest source of possible contamination: NA ft. _____ Direction _____ Type _____ Well disinfected upon completion? <input type="checkbox"/> Yes <input checked="" type="checkbox"/> No	
Gray shale & sandstone mixed				368		380		17. Pump: _____ Not installed Manufacturer's name Goulds Model number 12JLG HP 200 Volts _____ Length of drop pipe 440 ft. capacity 650 g.p.m. Type: <input type="checkbox"/> Submersible <input checked="" type="checkbox"/> Turbine <input type="checkbox"/> Jet <input type="checkbox"/> Reciprocating <input type="checkbox"/> Centrifugal <input type="checkbox"/> Other	
Gray shale				380		390		18. Water well contractor's certification: This well was drilled under my jurisdiction and this report is true to the best of my knowledge and belief. Ace-Hi International 190 Business name License No. _____ Address Dodge City, Kansas Signed Carl G. Little Date 5-15-76 Authorized Representative	
Good tan sandstone				390		398		19. Remarks: Shale BROCK 60' ppm 2495 (TOPO)	
Gray shale				398		401		Topography: <input checked="" type="checkbox"/> Hill <input type="checkbox"/> Slope <input type="checkbox"/> Upland <input type="checkbox"/> Valley	
Good tan sandstone				401		422		20. Remarks: WELL	
Gray sandstone with 35% shale mixed				422		435			
A-1 tan sandstone				435		475			
Shale				475		476			
Good sandstone				476		480			
Hard rock				480		481			
Gray shale				481		485			
Good tan sandstone (Use a second sheet if needed)				485		497			
21. Location:		22. Remarks: Shale BROCK 60' ppm 2495 (TOPO)							

21 250 32 SE NE 1/4 SW 1/4

Forward the white, blue and pink copies to the Department of Health and Environment

Form WWC-5