


WATER WELL RECORD Form WWC-5 KSA 82a-1212

1 LOCATION OF WATER WELL: Fraction Section Number Township Number Range Number  
 COUNTY: HODGEMAN NW 1/4 NW 1/4 NE 1/4 20 T 21 S R 25 W

Distance and direction from nearest town or city street address of well if located within city?  
 FROM JETHORE 10 WEST ON HIGHWAY 156, 9 NORTH & 1/2 WEST

2 WATER WELL OWNER: JACKSON, ROLAND  
 RR#, St. Address, Box #: ROUTE 1 -- BOX 74 Board of Agriculture, Division of Water Resources  
 City, State, ZIP code: JETHORE, KS 67854- Application Number:

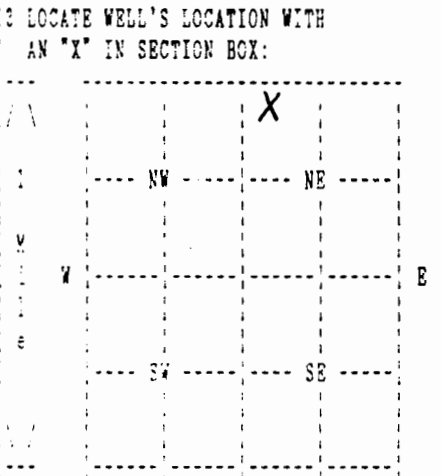

4 DEPTH OF COMPLETED WELL 60 ELEVATION: 0  
 Depth(s) Groundwater Encountered 1. 0 ft. 2. 0 ft. 3. 0 ft.  
 WELL'S STATIC WATER LEVEL 33 ft. below land surface measured on mo/day/yr 08/20/02  
 Pump test data: Well water was 0 ft. after 0 hours pumping 0 gpm  
 Estimated Yield 40 gpm: Well water was 0 ft. after 0 hours pumping 0 gpm  
 Bore Hole Diameter 10 in. to 60 ft., and in. to 0 ft.  
 WELL WATER TO BE USED AS: DOMESTIC  
 Was a chemical/bacteriological sample submitted to department? No ;  
 If yes, mo/day/yr sample was submitted Water well disinfected? Yes

5 TYPE OF BLANK CASING USED: PVC CASING JOINTS: GLUED  
 Blank casing diameter 5 in. to 60 ft., Dia in. to 0 ft., Dia in. to 0 ft. ..  
 Casing height above land surface 12 in., weight 200 lbs/ft. Wall thickness or gauge No. 21  
 TYPE OF SCREEN OR PERFORATION MATERIAL: PVC  
 SCREEN OR PERFORATION OPENINGS ARE: SAW CUT

SCREEN PERFORATED INTERVALS: From 35 ft. to 55 ft., From 0 ft. to 0 ft.  
 From 0 ft. to 0 ft., From 0 ft. to 0 ft.  
 GRAVEL PACK INTERVALS: From 25 ft. to 60 ft., From 0 ft. to 0 ft.  
 From 0 ft. to 0 ft., From 0 ft. to 0 ft.

6 GROUT MATERIAL BENTONITE  
 Grout Intervals: From 5 ft. to 25 ft., From 0 ft. to 0 ft., From 0 ft. to 0 ft.  
 What is the nearest source of possible contamination: NONE  
 Direction from well? How many feet? 0

FROM	TO	LITHOLOGIC LOG	FROM	TO	PLUGGING INTERVALS
0	20	01 TOPSOIL 05 CLAY			
20	40	05 CLAY 37 FIN-COAR SAN			
40	55	04 COARSE SAND 06 SMALL GRAVEL			
55	80	05 CLAY 07 BLUE SHALE			

7 CONTRACTOR'S OR LANDOWNER'S CERTIFICATION: This water well was Constructed under my jurisdiction and was completed on (mo/day/year) 08/23/02 and this record is true to the best of my knowledge and belief. Kansas Water Well Contractor's License No. 179 This Water Well Record was completed on (mo/day/yr) 09/03/02 under the business name of JOB'S WELL SERVICE, INC. by (signature) *Josiah Crick*