

WATER WELL RECORD Form WWC-5 KSA 82a-1212


1 LOCATION OF WATER WELL: Fraction Section Number Township Number Range Number
 COUNTY: HODGEMAN NE 1/4 SE 1/4 SW 1/4 16 T 21 S R 25 W

Distance and direction from nearest town or city street address of well if located within city?
 10 MILES WEST OF JETMORE ON 156 HIGHWAY - 10 MILES NORTH

2 WATER WELL OWNER: RINNE, ROBERT & PEGGY
 RE#, St. Address, Box #: 2648 CASCADIA AVE. SOUTH Board of Agriculture, Division of Water Resources
 City, State, ZIP code: SEATTLE, WA 98144- Application Number: 8473

3 LOCATE WELL'S LOCATION WITH AN "X" IN SECTION BOX:

4 DEPTH OF COMPLETED WELL 70 ELEVATION: 0
 Depth(s) Groundwater Encountered 1. 0 ft. 2. 0 ft. 3. 0 ft.

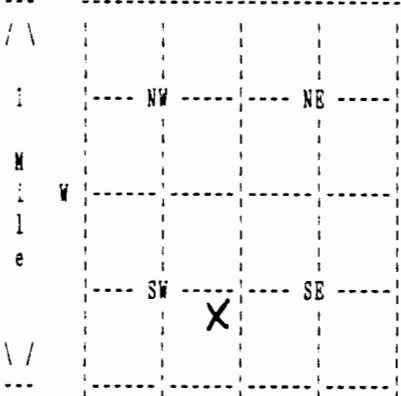

WELL'S STATIC WATER LEVEL 28 ft. below land surface measured on mo/day/yr 07/30/03
 Pump test data: Well water was 0 ft. after 0 hours pumping 0 gpm
 Estimated Yield 300 gpm: Well water was 0 ft. after 0 hours pumping 0 gpm
 Bore Hole Diameter 26 in. to 70 ft., and in. to 0 ft.
 WELL WATER TO BE USED AS: IRRIGATION

Was a chemical/bacteriological sample submitted to department? No ;
 If yes, mo/day/yr sample was submitted Water well disinfected? Yes

5 TYPE OF BLANK CASING USED: PVC CASING JOINTS: GLUED
 Blank casing diameter 16 in. to 70 ft., Dia in. to 0 ft., Dia in. to 0 ft. .
 Casing height above land surface 12 in., weight 200 lbs/ft. Wall thickness or gauge No. 21
 TYPE OF SCREEN OR PERFORATION MATERIAL: PVC
 SCREEN OR PERFORATION OPENINGS ARE: SAW CUT

SCREEN PERFORATED INTERVALS: From 40 ft. to 70 ft., From 0 ft. to 0 ft.
 From 0 ft. to 0 ft., From 0 ft. to 0 ft.
 GRAVEL PACK INTERVALS: From 20 ft. to 70 ft., From 0 ft. to 0 ft.
 From 0 ft. to 0 ft., From 0 ft. to 0 ft.

6 GROUT MATERIAL BENTONITE
 Grout Intervals: From 0 ft. to 20 ft., From 0 ft. to 0 ft., From 0 ft. to 0 ft.
 What is the nearest source of possible contamination: ABANDONED WELL
 Direction from well? SOUTH How many feet? 20

FROM	TO	LITHOLOGIC LOG	FROM	TO	PLUGGING INTERVALS
0	20	01 TOPSOIL 05 CLAY			
20	48	32 TAN CLAY 36 BLUE CLAY			
48	63	37 FIN-COAR SAN 38 SMAL-MED GRA			
63	80	08 ROCK LAYERS 07 BLUE SHALE			

7 CONTRACTOR'S OR LANDOWNER'S CERTIFICATION: This water well was Constructed under my jurisdiction and was completed on (mo/day/year) 07/30/03 and this record is true to the best of my knowledge and belief. Kansas Water Well Contractor's License No. 179 This Water Well Record was completed on (mo/day/yr) 08/04/03 under the business name of JOB'S WELL SERVICE, INC. by (signature) *Josiah Crist*