

**WATER WELL RECORD Form WWC-5**


Original Record  Correction  Change in Well Use

Division of Water Resources App. No.  

Well ID  

<b>1 LOCATION OF WATER WELL:</b> County: <b>Hodgeman</b>	Fraction NE ¼ SE ¼ SE ¼ SE ¼	Section Number <b>1</b>	Township Number <b>T 21 S</b>	Range Number <b>R 25</b> <input type="checkbox"/> E <input checked="" type="checkbox"/> W
---	---------------------------------	----------------------------	----------------------------------	--

<b>2 WELL OWNER:</b> Last Name: <b>Goebel</b> First: <b>Lynn</b> Business: _____ Address: <b>NW 217 Rd</b> Address: _____ City: <b>Jetmore</b> State: <b>KS</b> ZIP: <b>67854</b>	Street or Rural Address where well is located (if unknown, distance and direction from nearest town or intersection): If at owner's address, check here: <input type="checkbox"/> <b>Co. Rd X &amp; 212 Rd</b> <b>1/8 Mile N west side</b>
---	--

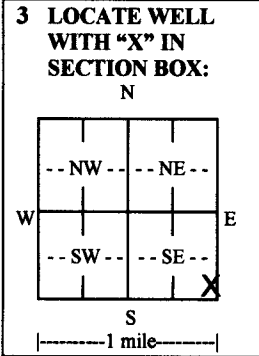

**4 DEPTH OF COMPLETED WELL:** ..... **55** ..... ft.

Depth(s) Groundwater Encountered: 1) ..... **37** ..... ft.  
 2) ..... ft. 3) ..... ft., or 4)  Dry Well

WELL'S STATIC WATER LEVEL: ..... **37** ..... ft.  
 below land surface, measured on (mo-day-yr) **01/07/2016**  
 above land surface, measured on (mo-day-yr) .....

Pump test data: Well water was ..... ft. after ..... hours pumping ..... gpm  
 Well water was ..... ft. after ..... hours pumping ..... gpm

Estimated Yield: ..... **0** ..... gpm  
 Bore Hole Diameter: ..... **10** ..... in. to ..... **55** ..... ft. and ..... in. to ..... ft.

**5 Latitude:** ..... **38.248202** ..... (decimal degrees)  
**Longitude:** ..... **100.009957** ..... (decimal degrees)  
 Datum:  WGS 84  NAD 83  NAD 27  
**Source for Latitude/Longitude:**  
 GPS (unit make/model: .....)  
 (WAAS enabled?  Yes  No)  
 Land Survey  Topographic Map  
 Online Mapper: .....

**6 Elevation:** **2303** ..... ft.  Ground Level  TOC  
**Source:**  Land Survey  GPS  Topographic Map  
 Other **KOLAR** .....

**7 WELL WATER TO BE USED AS:**

1. Domestic: <input type="checkbox"/> Household <input type="checkbox"/> Lawn & Garden <input checked="" type="checkbox"/> Livestock 2. <input type="checkbox"/> Irrigation 3. <input type="checkbox"/> Feedlot 4. <input type="checkbox"/> Industrial	5. <input type="checkbox"/> Public Water Supply: well ID .....	10. <input type="checkbox"/> Oil Field Water Supply: lease .....
6. <input type="checkbox"/> Dewatering: how many wells? .....	7. <input type="checkbox"/> Aquifer Recharge: well ID .....	11. Test Hole: well ID .....
8. <input type="checkbox"/> Monitoring: well ID .....	9. Environmental Remediation: well ID .....	<input type="checkbox"/> Cased <input type="checkbox"/> Uncased <input type="checkbox"/> Geotechnical
<input type="checkbox"/> Air Sparge <input type="checkbox"/> Soil Vapor Extraction	<input type="checkbox"/> Recovery <input type="checkbox"/> Injection	12. Geothermal: how many bores? .....
		a) Closed Loop <input type="checkbox"/> Horizontal <input type="checkbox"/> Vertical b) Open Loop <input type="checkbox"/> Surface Discharge <input type="checkbox"/> Inj. of Water
		13. <input type="checkbox"/> Other (specify): .....

Was a chemical/bacteriological sample submitted to KDHE?  Yes  No If yes, date sample was submitted: .....

Water well disinfected?  Yes  No

**8 TYPE OF CASING USED:**  Steel  PVC  Other ..... CASING JOINTS:  Glued  Clamped  Welded  Threaded

Casing diameter ..... **6** ..... in. to ..... **55** ..... ft., Diameter ..... in. to ..... ft., Diameter ..... in. to ..... ft.  
 Casing height above land surface ..... **12** ..... in. Weight ..... lbs./ft. Wall thickness or gauge No. **SDR21** .....

**TYPE OF SCREEN OR PERFORATION MATERIAL:**  
 Steel  Stainless Steel  Fiberglass  PVC  Other (Specify) .....

Brass  Galvanized Steel  Concrete tile  None used (open hole)

**SCREEN OR PERFORATION OPENINGS ARE:**  
 Continuous Slot  Mill Slot  Gauze Wrapped  Torch Cut  Drilled Holes  Other (Specify) .....

Louvered Shutter  Key Punched  Wire Wrapped  Saw Cut  None (Open Hole)

**SCREEN-PERFORATED INTERVALS:** From ..... **20** ..... ft. to ..... **55** ..... ft., From ..... ft. to ..... ft., From ..... ft. to ..... ft.  
**GRAVEL PACK INTERVALS:** From ..... **15** ..... ft. to ..... **55** ..... ft., From ..... ft. to ..... ft., From ..... ft. to ..... ft.

**9 GROUT MATERIAL:**  Neat cement  Cement grout  Bentonite  Other .....

Grout Intervals: From ..... **0** ..... ft. to ..... **15** ..... ft., From ..... ft. to ..... ft., From ..... ft. to ..... ft.

**Nearest source of possible contamination:**

<input type="checkbox"/> Septic Tank	<input type="checkbox"/> Lateral Lines	<input type="checkbox"/> Pit Privy	<input type="checkbox"/> Livestock Pens	<input type="checkbox"/> Insecticide Storage
<input type="checkbox"/> Sewer Lines	<input type="checkbox"/> Cess Pool	<input type="checkbox"/> Sewage Lagoon	<input type="checkbox"/> Fuel Storage	<input type="checkbox"/> Abandoned Water Well
<input type="checkbox"/> Watertight Sewer Lines	<input type="checkbox"/> Seepage Pit	<input type="checkbox"/> Feedyard	<input type="checkbox"/> Fertilizer Storage	<input type="checkbox"/> Oil Well/Gas Well
<input type="checkbox"/> Other (Specify) .....				

Direction from well? ..... Distance from well? ..... ft.

10 FROM	TO	LITHOLOGIC LOG	FROM	TO	LITHO. LOG (cont.) or PLUGGING INTERVALS
0	16	Fine Sand, Tan Clay			
16	23	Fine Med Sand			
23	30	Fome Coarse Sand, Small gravel			
30	35	Kept loosing circulation			
35	40	Fine Coarse sand with small to med grave			
40	41	Hard Rock			
41	55	Blue Shale			
<b>Notes:</b>					

**11 CONTRACTOR'S OR LANDOWNER'S CERTIFICATION:** This water well was  constructed,  reconstructed, or  plugged under my jurisdiction and was completed on (mo-day-yr) **01/07/2016** ..... and this record is true to the best of my knowledge and belief. Kansas Water Well Contractor's License No. **846** ..... This Water Well Record was completed on (mo-day-yr) **01/12/2016** ..... under the business name of **Nash Water Well Service, LLC** .....