

CORRECTION(S) TO WATER WELL RECORD (WWC-5)

(to rectify lacking or incorrect information)

Location listed as:

Section-Township-Range: 7-21-26 EFraction ($\frac{1}{4}$ $\frac{1}{4}$ $\frac{1}{4}$): SE SE NWCounty: Hodgeman

Location changed to:

7-21-26WSE SE NW

Other changes: Initial statements: _____

Changed to: _____


Comments: E changed to Wverification method: County maps, address and location informationinitials: MS date: 3-3-06submitted by: Kansas Geological Survey, Data Resources Library, 1930 Constant Ave., Lawrence, KS 66047-3726
to: Kansas Dept of Health & Environment, Bureau of Water, 1000 SW Jackson, Suite 420, Topeka, KS 66612-1367.

WATER WELL RECORD Form WWC-5 KSA 82a-1212

1 LOCATION OF WATER WELL: Fraction Section Number Township Number Range Number
 COUNTY: HODGEMAN SE 1/4 SE 1/4 NW 1/4 7 T 21 S R 26 E

Distance and direction from nearest town or city street address of well if located within city?
 FROM KALVESTA - 3 E ON 156 TO PINNEY-HODGEMAN LINE, 12 NORTH

2 WATER WELL OWNER: DUHLER, ROGER
 RR#, St. Address, Box #: Board of Agriculture, Division of Water Resources
 City, State, ZIP code: KALVESTA, KS 67856- Application Number:

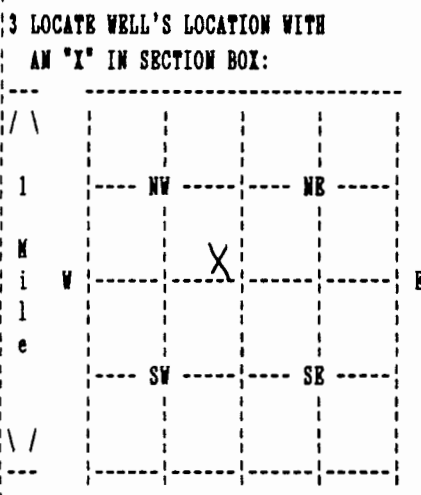

4 DEPTH OF COMPLETED WELL 625 ELEVATION: 0
 Depth(s) Groundwater Encountered 1. 0 ft. 2. 0 ft. 3. 0 ft.
 WELL'S STATIC WATER LEVEL 350 ft. below land surface measured on mo/day/yr 12/12/05
 Pump testdata: Well water was 0 ft. after 0 hours pumping 0 gpm
 Estimated Yield 40 gpm: Well water was 0 ft. after 0 hours pumping 0 gpm
 Bore Hole Diameter 9 in. to 625 ft., and in. to 0 ft.
 WELL WATER TO BE USED AS: DOMESTIC
 Was a chemical/bacteriological sample submitted to department? No ;
 If yes, mo/day/yr sample was submitted Water well disinfected? Yes

5 TYPE OF BLANK CASING USED: CERTA LOC CASIN CASING JOINTS: CERTA-LOC
 Blank casing diameter 5 in. to 625 ft., Dia in. to 0 ft., Dia in. to 0 ft.
 Casing height above land surface 12 in., weight 200 lbs/ft. Wall thickness or gauge No. 17-80(Sch)
 TYPE OF SCREEN OR PERFORATION MATERIAL: PVC
 SCREEN OR PERFORATION OPENINGS ARE: SAW CUT

SCREEN PERFORATED INTERVALS: From 480 ft. to 620 ft., From 0 ft. to 0 ft.
 From 0 ft. to 0 ft., From 0 ft. to 0 ft.
 GRAVEL PACK INTERVALS: From 30 ft. to 625 ft., From 0 ft. to 0 ft.
 From 0 ft. to 0 ft., From 0 ft. to 0 ft.

6 GROUT MATERIAL BENTONITE
 Grout Intervals: From 5 ft. to 30 ft., From 0 ft. to 0 ft., From 0 ft. to 0 ft.
 What is the nearest source of possible contamination: NONE
 Direction from well? How many feet? 0

FROM	TO	LITHOLOGIC LOG	FROM	TO	PLUGGING INTERVALS
0	20	01 TOPSOIL 32 TAN CLAY			
20	60	32 TAN CLAY 16 GRAY CLAY 08 ROCK LAYERS			
60	80	16 GRAY CLAY 36 BLUE CLAY			
80	320	36 BLUE CLAY 31 SHALE			
320	415	07 BLUE SHALE 24 THINROCLAYER			
415	418	27 ROCK			
418	440	24 THINROCLAYER 16 GRAY CLAY			
440	460	16 GRAY CLAY 29 SANDSTONE			
460	640	29 SANDSTONE			

7 CONTRACTOR'S OR LANDOWNER'S CERTIFICATION: This water well was Constructed under my jurisdiction and was completed on (mo/day/year) 12/26/05 and this record is true to the best of my knowledge and belief. Kansas Water Well Contractor's License No. 179 This Water Well Record was completed on (mo/day/yr) 02/03/06 under the business name of JOB'S WELL SERVICE, INC. by (signature) *Juill Critt*