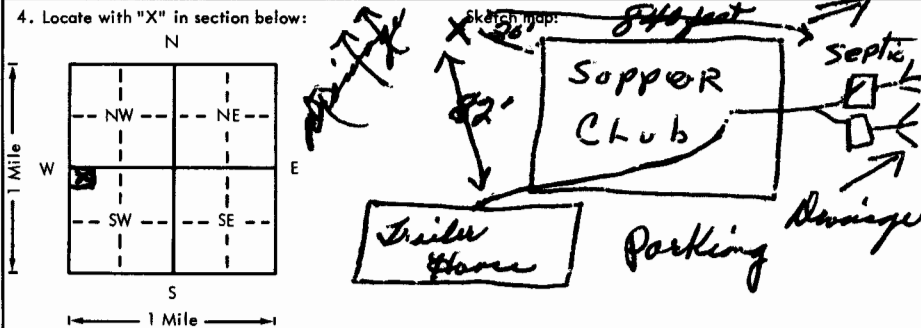


USE TYPEWRITER OR BALL  
POINT PEN-PRESS FIRMLY,  
PRINT CLEARLY.

WATER WELL RECORD  
KSA 82a-1201-1215

Kansas Department of Health and  
Environment-Division of Environment  
(Water well Contractors)  
Topeka, Kansas 66620

1. Location of well:		County <i>McPherson</i>	Fraction <i>NW 1/4 NW 1/4 SW 1/4</i>	Section number <i>9</i>	Township number <i>T 21 S</i>	Range number <i>R 3 E</i>
2. Distance and direction from nearest town or city: <i>Emmon Kans.</i>		3. Owner of well: <i>HOWARD HUBER</i>		R.R. or street: <i>PRI INMAN, KANS.</i>		
Street address of well location if in city: <i>6 E. Y2N.</i>		City, state, zip code:				
4. Locate with "X" in section below: 				6. Bore hole dia. <i>8"</i> in. Completion date <i>8-12-76</i> Well depth <i>146</i> ft.		
5. Type and color of material				7. <input checked="" type="checkbox"/> Cable tool <input checked="" type="checkbox"/> Rotary <input type="checkbox"/> Driven <input type="checkbox"/> Dug <input type="checkbox"/> Hollow rod <input type="checkbox"/> Jetted <input type="checkbox"/> Bored <input type="checkbox"/> Reverse rotary		
8. Use: <input checked="" type="checkbox"/> Domestic <input checked="" type="checkbox"/> Public supply <input type="checkbox"/> Industry <input type="checkbox"/> Irrigation <input type="checkbox"/> Air conditioning <input type="checkbox"/> Stock <input type="checkbox"/> Lawn <input type="checkbox"/> Oil field water <input type="checkbox"/> Other				9. Casing: Material <i>PLST</i> Height: <i>Above</i> or below Threaded <input type="checkbox"/> Welded <input checked="" type="checkbox"/> Surface <i>18</i> in. RMP <input type="checkbox"/> PVC <input checked="" type="checkbox"/> Weight <input type="checkbox"/> lbs./ft. Dia. <i>5</i> in. to <i>146</i> ft. depth Wall Thickness: inches or Dia. <input type="checkbox"/> in. to <input type="checkbox"/> ft. depth Gage No. <i>74"</i>		
10. Screen: Manufacturer's name <i>Jet Stream</i> <i>Ralph Jones</i> Type <i>P.V.C.</i> Dia. <i>5"</i> Slot/gauze <i>732</i> Length <i>20'</i> Set between <i>126</i> ft. and <i>146</i> ft. <input type="checkbox"/> ft. and <input type="checkbox"/> ft. Gravel pack? <i>yes</i> Size range of material <i>18-24"</i>				11. Static water level: <input type="checkbox"/> mo./day/yr. <i>41</i> ft. below land surface Date <i>8-12-76</i>		
12. Pumping level below land surfaces: <i>41</i> ft. after <i>2 1/2</i> hrs. pumping <i>8</i> g.p.m. <input type="checkbox"/> ft. after <input type="checkbox"/> hrs. pumping <input type="checkbox"/> g.p.m. Estimated maximum yield <i>30</i> g.p.m.				13. Water sample submitted: <input type="checkbox"/> mo./day/yr. <input checked="" type="checkbox"/> Yes <input checked="" type="checkbox"/> No Date <input type="checkbox"/>		
14. Well head completion: <input checked="" type="checkbox"/> Pitless adapter <i>12</i> inches above grade				15. Well grouted? <i>yes</i> With: <input checked="" type="checkbox"/> Neat cement <input type="checkbox"/> Bentonite <input type="checkbox"/> Concrete Depth: From <i>4</i> ft. to <i>15</i> ft.		
16. Nearest source of possible contamination: <i>Gravel</i> ft. <i>82</i> Direction <i>W</i> Type <i>Line</i> Well disinfected upon completion? <input checked="" type="checkbox"/> Yes <input type="checkbox"/> No				17. Pump: <input checked="" type="checkbox"/> Not installed Manufacturer's name <input type="checkbox"/> Model number <input type="checkbox"/> HP <input type="checkbox"/> Volts <input type="checkbox"/> Length of drop pipe <input type="checkbox"/> ft. capacity <input type="checkbox"/> g.p.m. Type: <input type="checkbox"/> Submersible <input type="checkbox"/> Turbine <input type="checkbox"/> Jet <input type="checkbox"/> Reciprocating <input type="checkbox"/> Centrifugal <input type="checkbox"/> Other		
18. Elevation:				20. Water well contractor's certification: This well was drilled under my jurisdiction and this report is true to the best of my knowledge and belief. <i>Peterson Bros. Inc.</i> <i>138</i> Business name License No. Address <i>Box 150 Lindborg, KS</i> Signed <i>Wally Peterson</i> Date <i>8-12-76</i> Authorized representative		
19. Remarks: <i>The customer will install Pumps. Mr. Huber knows about 4 ft of slab around Pitless Adapter.</i>						