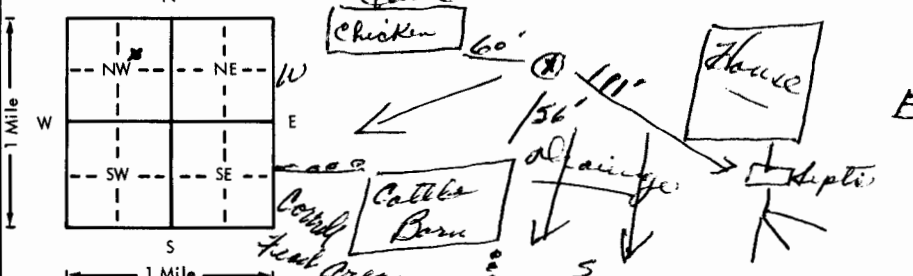


USE TYPEWRITER OR BALL
POINT PEN-PRESS FIRMLY,
PRINT CLEARLY.

WATER WELL RECORD
KSA 82a-1201-1215

Kansas Department of Health and
Environment-Division of Environment
(Water well Contractors)
Topeka, Kansas 66620

1. Location of well: County <u>McPherson</u> Fraction <u>S 1/4 NE 1/4 NW 1/4</u> Section number <u>17</u> Township number <u>T 21 S R 3</u> Range number <u>3</u> (E/W)	
2. Distance and direction from nearest town or city: <u>5 1/2 E of Inman Kans.</u> Street address of well location if in city: <u>Inman Kans.</u>	
3. Owner of well: <u>DAN THIESSEN</u> R.R. or street: <u>RRF</u> City, state, zip code: <u>INMAN KANS 67546</u>	
4. Locate with "X" in section below: Sketch map: <u>N</u> 	
5. Type and color of material	
6. Bore hole dia. <u>8</u> in. Completion date <u>10-8-76</u> Well depth <u>142</u> ft.	
7. <input checked="" type="checkbox"/> Cable tool <input checked="" type="checkbox"/> Rotary <input type="checkbox"/> Driven <input type="checkbox"/> Dug <input type="checkbox"/> Hollow rod <input type="checkbox"/> Jetted <input type="checkbox"/> Bored <input type="checkbox"/> Reverse rotary	
8. Use: <input checked="" type="checkbox"/> Domestic <input type="checkbox"/> Public supply <input type="checkbox"/> Industry <input type="checkbox"/> Irrigation <input type="checkbox"/> Air conditioning <input type="checkbox"/> Stock <input type="checkbox"/> Lawn <input type="checkbox"/> Oil field water <input type="checkbox"/> Other	
9. Casing: Material <u>PVC</u> Height <u>Above</u> or below Threaded <input type="checkbox"/> Welded <input checked="" type="checkbox"/> Surface <u>12</u> in. RMP <input type="checkbox"/> PVC <input checked="" type="checkbox"/> Weight <u>10</u> lbs./ft. Dia. <u>4</u> in. to <u>130</u> ft. depth Wall Thickness: inches or Dia. <u>1/4</u> in. to <u>140</u> ft. depth gage No. <u>14</u>	
10. Screen: Manufacturer's name <u>Certain Steel</u> <u>Certain Steel - McPherson</u> Type <u>PVC</u> Dia. <u>4</u> in. Slot/gauze <u>1/16</u> Length <u>10</u> ft. Set between <u>130</u> ft. and <u>140</u> ft. Gravel pack? <u>Yes</u> Size range of material <u>1/8-1/4</u>	
11. Static water level: <u>27</u> ft. below land surface Date <u>10-8-76</u>	
12. Pumping level below land surfaces: <u>36</u> ft. after <u>3</u> hrs. pumping <u>15</u> g.p.m. ____ ft. after ____ hrs. pumping ____ g.p.m. Estimated maximum yield <u>50</u> g.p.m.	
13. Water sample submitted: <u>Yes</u> <input checked="" type="checkbox"/> No <input type="checkbox"/> Date ____	
14. Well head completion: <u>Pump & House</u> <input checked="" type="checkbox"/> Pitless adapter <u>1</u> inches above grade	
15. Well grouted? <u>Yes</u> With: <input checked="" type="checkbox"/> Neat cement <input type="checkbox"/> Bentonite <input type="checkbox"/> Concrete Depth: From <u>0</u> ft. to <u>14</u> ft.	
16. Nearest source of possible contamination: <u>Barn</u> ft. <u>56</u> Direction <u>S.W.</u> Type <u>Barn</u> Well disinfected upon completion? <input checked="" type="checkbox"/> Yes <input type="checkbox"/> No	
17. Pump: <input checked="" type="checkbox"/> Not installed Manufacturer's name _____ Model number _____ HP _____ Volts _____ Length of drop pipe _____ ft. capacity _____ g.p.m. Type: _____ <input type="checkbox"/> Submersible <input type="checkbox"/> Turbine <input type="checkbox"/> Jet <input type="checkbox"/> Reciprocating <input type="checkbox"/> Centrifugal <input type="checkbox"/> Other	
18. Elevation: Topography: <input checked="" type="checkbox"/> Hill <input checked="" type="checkbox"/> Slope <input type="checkbox"/> Upland <input type="checkbox"/> Valley	
19. Remarks: <u>Mr. Thiesen will build pump house & install his own pump. He knows regulation on 4' slab.</u>	
20. Water well contractor's certification: This well was drilled under my jurisdiction and this report is true to the best of my knowledge and belief. <u>Peterson Bros</u> <u>138</u> Business name License No. Address <u>Box 150 Lindsborg Kans</u> Signed <u>Dale Peterson</u> Date <u>10-12-76</u> Authorized representative	