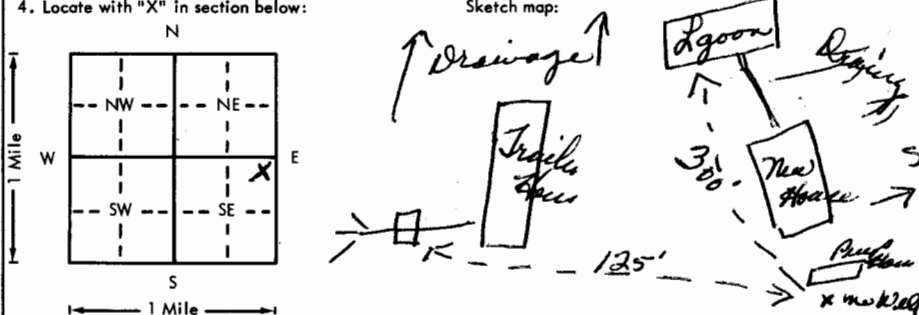


USE TYPEWRITER OR BALL  
POINT PEN-PRESS FIRMLY,  
PRINT CLEARLY.

WATER WELL RECORD  
KSA 82a-1201-1215

Kansas Department of Health and  
Environment-Division of Environment  
(Water well Contractors)  
Topeka, Kansas 66620

1. Location of well:		County <u>McPherson</u>	Fraction <u>NE 1/4 NE 1/4 SE 1/4</u>	Section number <u>17</u>	Township number <u>T 21 S R 3</u>	Range number <u>3</u>
2. Distance and direction from nearest town or city: <u>6E - 1/2 S</u>		3. Owner of well: <u>Harry Armstrong</u>				
Street address of well location if in city: <u>Inman Kans.</u>		R.R. or street: <u>RR1 - Box 123</u>				
		City, state, zip code: <u>Inman, Kans.</u>				
4. Locate with "X" in section below:		Sketch map:		6. Bore hole dia. <u>8"</u> in. Completion date <u>8-20-76</u>		
				Well depth <u>100</u> ft.		
5. Type and color of material		From To		7. <input checked="" type="checkbox"/> Cable tool <input checked="" type="checkbox"/> Rotary <input type="checkbox"/> Driven <input type="checkbox"/> Dug		
<u>Top Soil</u>		<u>0 2</u>		<input type="checkbox"/> Hollow rod <input type="checkbox"/> Jetted <input type="checkbox"/> Bored <input type="checkbox"/> Reverse rotary		
<u>Black Clays</u>		<u>2 8</u>		8. Use: <input checked="" type="checkbox"/> Domestic <input type="checkbox"/> Public supply <input type="checkbox"/> Industry		
<u>Red Clays</u>		<u>8 12</u>		<input type="checkbox"/> Irrigation <input type="checkbox"/> Air conditioning <input type="checkbox"/> Stock		
<u>Buff silty clays</u>		<u>12 21</u>		<input type="checkbox"/> Lawn <input type="checkbox"/> Oil field water <input type="checkbox"/> Other		
<u>Very Very fine sands &amp; silty clay</u>		<u>21 47</u>		9. Casing: Material <u>PLT</u> Height: <u>Above</u> or below		
<u>Gray clays</u>		<u>47 53</u>		Threaded <input type="checkbox"/> Welded <input checked="" type="checkbox"/> Surface <u>18"</u> in.		
<u>Fine sands</u>		<u>53 60</u>		RMP <input type="checkbox"/> PVC <input checked="" type="checkbox"/> Weight <u>15</u> lbs./ft.		
<u>Tight med sands</u>		<u>60 74</u>		Dia. <u>5</u> in. to <u>90</u> ft. depth Wall Thickness: inches or		
<u>Gray clays</u>		<u>74 86</u>		Dia. <u>5</u> in. to <u>90</u> ft. depth gage No. <u>18</u>		
<u>Med sands - Lagoon</u>		<u>86 110</u>		10. Screen: Manufacturer's name <u>Jet Screen</u>		
				<u>Winrock Inc.</u>		
				Type <u>P.V.C.</u> Dia. <u>5"</u>		
				Slot/gauze <u>1/16</u> Length <u>10 ft</u>		
				Set between <u>90</u> ft. and <u>100</u> ft.		
				<u>90</u> ft. and <u>100</u> ft.		
				Gravel pack? <input checked="" type="checkbox"/> Size range of material <u>1/4-1/2</u>		
				11. Static water level: <u>38</u> ft. below land surface Date <u>8-20-76</u>		
				12. Pumping level below land surfaces:		
				<u>85</u> ft. after <u>1 1/2</u> hrs. pumping <u>15</u> g.p.m.		
				<u>60</u> ft. after <u>2</u> hrs. pumping <u>8</u> g.p.m.		
				Estimated maximum yield <u>40-30</u> g.p.m.		
				13. Water sample submitted: <u>mo./day/yr.</u>		
				Yes <input checked="" type="checkbox"/> No <input type="checkbox"/> Date <u>8-20-76</u>		
				14. Well head completion:		
				<input checked="" type="checkbox"/> Pitless adapter <u>18"</u> inches above grade		
				15. Well grouted? <input checked="" type="checkbox"/>		
				With: <input checked="" type="checkbox"/> Neat cement <input type="checkbox"/> Bentonite <input type="checkbox"/> Concrete		
				Depth: From <u>4</u> ft. to <u>16</u> ft.		
				16. Nearest source of possible contamination:		
				ft. <u>125</u> Direction <u>N</u> Type <u>Septic</u>		
				Well disinfected upon completion? <input checked="" type="checkbox"/> Yes <input type="checkbox"/> No		
				17. Pump: <input checked="" type="checkbox"/> Not installed		
				Manufacturer's name <u>Peterson Bros Inc</u>		
				Model number <u>138</u> HP <u>1</u> Volts <u>115</u>		
				Length of drop pipe <u>10</u> ft. capacity <u>1</u> g.p.m.		
				Type:		
				<input type="checkbox"/> Submersible <input type="checkbox"/> Turbine		
				<input type="checkbox"/> Jet <input type="checkbox"/> Reciprocating		
				<input type="checkbox"/> Centrifugal <input type="checkbox"/> Other		
18. Elevation:		19. Remarks:		20. Water well contractor's certification:		
Topography: <input type="checkbox"/> Hill		<u>The Armstrong will pour 4 ft. sq slab</u>		This well was drilled under my jurisdiction and this report		
<input checked="" type="checkbox"/> Slope		<u>around well &amp; install Pitless Adapter</u>		is true to the best of my knowledge and belief.		
<input checked="" type="checkbox"/> Upland		<u>and his own pump. He knows</u>		<u>Peterson Bros Inc</u> <u>138</u>		
<input type="checkbox"/> Valley		<u>the state regulation.</u>		Business name <u>Peterson Bros Inc</u> License No. <u>67430</u>		
