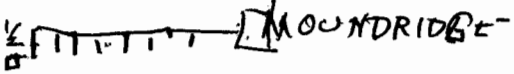


USE TYPEWRITER OR BALL
POINT PEN-PRESS FIRMLY,
PRINT CLEARLY.

WATER WELL RECORD
KSA 82a-1201-1215

Kansas Department of Health and
Environment-Division of Environment
(Water well Contractors)
Topeka, Kansas 66620

1. Location of well:		County <u>McPherson</u>	Fraction <u>1/4 NW 1/4 NE 1/4 SE 15</u>	Section number <u>15</u>	Township number <u>T 21</u>	Range number <u>S R 3 W</u>
2. Distance and direction from nearest town or city: <u>4 W - 1/2 S MOONDRIDGE, KS. 4 miles East of</u> Street address of well location if in city: <u>Moundridge-Mcpherson rd.</u> <u>1/2 Mi. South on west side</u>		3. Owner of well: <u>Blackstone Drilling Co.</u> R.R. or street: <u>P.O. Box 1184</u> City, state, zip code: <u>McPherson, Kansas 67460</u>				
4. Locate with "X" in section below: N W E S 1 Mile		Sketch map: 		6. Bore hole dia. <u>6</u> in. Completion date Well depth <u>105</u> ft. <u>11/19/77</u>		
5. Type and color of material		From	To	7. <input checked="" type="checkbox"/> Cable tool <input checked="" type="checkbox"/> Rotary <input type="checkbox"/> Driven <input type="checkbox"/> Dug <input type="checkbox"/> Hollow rod <input type="checkbox"/> Jetted <input type="checkbox"/> Bored <input type="checkbox"/> Reverse rotary		
				8. Use: <input type="checkbox"/> Domestic <input type="checkbox"/> Public supply <input type="checkbox"/> Industry <input type="checkbox"/> Irrigation <input type="checkbox"/> Air conditioning <input type="checkbox"/> Stock <input type="checkbox"/> Lawn <input checked="" type="checkbox"/> Oil field water <input type="checkbox"/> Other		
				9. Casing: Material <u>Plastic</u> Height: Above or below Threaded <input type="checkbox"/> Welded <input type="checkbox"/> Surface <u>18</u> in. RMP <input type="checkbox"/> PVC <input checked="" type="checkbox"/> Weight <u>216</u> lbs./ft. Dia. <u>3</u> in. to <u>0</u> ft. depth Wall Thickness: inches <u>216</u> Dia. <u>3</u> in. to <u>83</u> ft. depth gage No. <u>216</u>		
				10. Screen: Manufacturer's name <u>Certain Teed</u> Type <u>sawed</u> Dia. <u>3</u> Slot/gauze <u>8</u> Length <u>10</u> Set between <u>85</u> ft. and <u>105</u> ft. ft. and <u>105</u> ft. Gravel pack? <u>yes</u> Size range of material <u>1/8-1/4</u>		
				11. Static water level: <u>41</u> ft. below land surface Date <u>11/19/77</u> mo./day/yr.		
				12. Pumping level below land surfaces: <u>80</u> ft. after <u>1/2</u> hrs. pumping <u>30</u> g.p.m. ft. after <u> </u> hrs. pumping <u> </u> g.p.m. Estimated maximum yield <u>30</u> g.p.m.		
				13. Water sample submitted: <u> </u> mo./day/yr. <input type="checkbox"/> Yes <input checked="" type="checkbox"/> No Date <u> </u>		
				14. Well head completion: <input type="checkbox"/> Pitless adapter <u>18</u> inches above grade		
				15. Well grouted? <u>yes</u> With: <input type="checkbox"/> Neat cement <input checked="" type="checkbox"/> Bentonite <input type="checkbox"/> Concrete Depth: From <u>0</u> ft. to <u>10</u> ft.		
				<input checked="" type="checkbox"/> Nearest source of possible contamination: ft. <u> </u> Direction <u>None</u> Type <u> </u> Well disinfected upon completion? <input type="checkbox"/> Yes <input checked="" type="checkbox"/> No		
				17. Pump: <input checked="" type="checkbox"/> Not installed Manufacturer's name <u> </u> Model number <u> </u> HP <u> </u> Volts <u> </u> Length of drop pipe <u> </u> ft. capacity <u> </u> g.p.m. Type: <input type="checkbox"/> Submersible <input type="checkbox"/> Turbine <input type="checkbox"/> Jet <input type="checkbox"/> Reciprocating <input type="checkbox"/> Centrifugal <input type="checkbox"/> Other		
18. Elevation:		19. Remarks:		20. Water well contractor's certification: This well was drilled under my jurisdiction and this report is true to the best of my knowledge and belief. <u>Darling Drilling Co. 189</u> Business name License No. <u> </u> Address <u>Well W. W. Hutchinson, KS</u> Signed <u>Donald J. Ruby</u> Date <u>6-21-78</u> Authorized representative		
Topography: <input checked="" type="checkbox"/> Hill <input type="checkbox"/> Slope <input type="checkbox"/> Upland <input type="checkbox"/> Valley		(Use a second sheet if needed)				