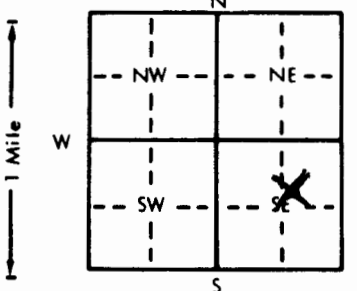


1 LOCATION OF WATER WELL:		Fraction	Section Number	Township Number	Range Number
County: McPherson		SW 1/4 NE 1/4 SE 1/4	29	T 21 S	R 3
Distance and direction from nearest town or city street address of well if located within city? 1 3/4 miles south & 7 miles east of Inman, KS					
2 WATER WELL OWNER: Milo Schroeder					
RR#, St. Address, Box # : 10600 E. 82 nd					
City, State, ZIP Code : Buhler, KS 67522					
Board of Agriculture, Division of Water Resources					
Application Number: redrill 10,642					
3 LOCATE WELL'S LOCATION WITH AN "X" IN SECTION BOX:		4 DEPTH OF COMPLETED WELL: 205 ft. ELEVATION:			
		Depth(s) Groundwater Encountered 1. 48 ft. 2. ft. 3. ft.			
		WELL'S STATIC WATER LEVEL 48 ft. below land surface measured on mo/day/yr 10-9-91			
		Pump test data: Well water was ft. after hours pumping gpm			
		Est. Yield gpm: Well water was ft. after hours pumping gpm			
		Bore Hole Diameter 30 in. to 205 ft., and in. to ft.			
		WELL WATER TO BE USED AS:			
		5 Public water supply 8 Air conditioning 11 Injection well			
		1 Domestic 3 Feedlot 6 Oil field water supply 9 Dewatering 12 Other (Specify below)			
		2 Irrigation 4 Industrial 7 Lawn and garden only 10 Monitoring well			
		Was a chemical/bacteriological sample submitted to Department? Yes No X; If yes, mo/day/yr sample was submitted			
		Water Well Disinfected? Yes X No			
5 TYPE OF BLANK CASING USED:					
1 Steel 3 RMP (SR) 5 Wrought iron 8 Concrete tile CASING JOINTS: Glued X Clamped					
2 PVC 4 ABS 6 Asbestos-Cement 9 Other (specify below) Welded					
7 Fiberglass Threaded					
Blank casing diameter 16 in. to 165 ft., Dia in. to ft., Dia in. to ft.					
Casing height above land surface 12 in., weight 16.15 lbs./ft. Wall thickness or gauge No. 500					
TYPE OF SCREEN OR PERFORATION MATERIAL:					
1 Steel 3 Stainless steel 5 Fiberglass 7 PVC 10 Asbestos-cement					
2 Brass 4 Galvanized steel 6 Concrete tile 8 RMP (SR) 11 Other (specify)					
9 ABS 12 None used (open hole)					
SCREEN OR PERFORATION OPENINGS ARE:					
1 Continuous slot 3 Mill slot 5 Gauzed wrapped 8 Saw cut 11 None (open hole)					
2 Louvered shutter 4 Key punched 6 Wire wrapped 9 Drilled holes					
7 Torch cut 10 Other (specify)					
SCREEN-PERFORATED INTERVALS: From 165 ft. to 205 ft., From ft. to ft.					
GRAVEL PACK INTERVALS: From 20 ft. to 80 ft., From ft. to ft.					
From 85 ft. to 205 ft., From ft. to ft.					
6 GROUT MATERIAL: 1 Neat cement 2 Cement grout 3 Bentonite 4 Other					
Grout Intervals: From 0 ft. to 20 ft., From 80 ft. to 85 ft., From ft. to ft.					
What is the nearest source of possible contamination:					
1 Septic tank 4 Lateral lines 7 Pit privy 10 Livestock pens 14 Abandoned water well					
2 Sewer lines 5 Cess pool 8 Sewage lagoon 11 Fuel storage 15 Oil well/Gas well					
3 Watertight sewer lines 6 Seepage pit 9 Feedyard 12 Fertilizer storage 16 Other (specify below)					
13 Insecticide storage					
Direction from well? South How many feet? 50 ft.					
FROM TO		LITHOLOGIC LOG		FROM TO PLUGGING INTERVALS	
0	3	Top Soil		177	178
3	24	Light Brown Clay		178	205
24	35	Tan Clay			
35	47	Medium Sand			
47	57	Tan Clay			
57	63	Fine to Medium Sand			
63	88	Tan Clay			
88	97	Medium Sand			
97	113	Gray Clay			
113	137	Fien to Medium Sand			
137	147	Gray Clay			
147	153	Tan Clay			
153	164	Medium Sand			
164	165	Gray Clay			
165	174	Medium Sand			
7 CONTRACTOR'S OR LANDOWNER'S CERTIFICATION: This water well was (1) constructed, (2) reconstructed, or (3) plugged under my jurisdiction and was completed on (mo/day/year) 10-9-91 and this record is true to the best of my knowledge and belief. Kansas					
Water Well Contractor's License No. 138 This Water Well Record was completed on (mo/day/yr) 10-14-91					
under the business name of Peterson Irrigation, Inc. by (signature) Mike Peterson					