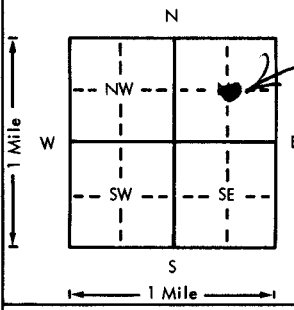


USE TYPEWRITER OR BALL
POINT PEN-PRESS FIRMLY,
PRINT CLEARLY.

WATER WELL RECORD
KSA 82a-1201-1215

Kansas Department of Health and
Environment-Division of Environment
(Water well Contractors)
Topeka, Kansas 66620

1. Location of well: County <u>McPherson</u>		Fraction <u>Center</u> <u>1/4 of NE 1/4</u>		Section number <u>35</u>		Township number <u>T 21</u>		Range number <u>S R 3</u> <u>NW</u>	
2. Distance and direction from nearest town or city: Street address of well location if in city: <u>4 W 250 of Moundridge, KS</u>				3. Owner of well: <u>Leland Goering</u> R.R. or street: <u>RR 1</u> City, state, zip code: <u>Moundridge, Kansas</u>					
4. Locate with "X" in section below: 				Sketch map:		6. Bore hole dia. <u>3.0</u> in. Completion date <u>7-5</u> Well depth <u>125</u> ft. <u>26</u>			
5. Type and color of material				From		To		7. <input type="checkbox"/> Cable tool <input type="checkbox"/> Rotary <input type="checkbox"/> Driven <input type="checkbox"/> Dug <input type="checkbox"/> Hollow rod <input type="checkbox"/> Jetted <input type="checkbox"/> Bored <input checked="" type="checkbox"/> Reverse rotary	
Top Soil				0		2		8. Use: <input type="checkbox"/> Domestic <input type="checkbox"/> Public supply <input type="checkbox"/> Industry <input checked="" type="checkbox"/> Irrigation <input type="checkbox"/> Air conditioning <input type="checkbox"/> Stock <input type="checkbox"/> Lawn <input type="checkbox"/> Oil field water <input type="checkbox"/> Other	
Clay - Dark				2		7		9. Casing: Material <u>Pump</u> Height: Above or below Threaded <input type="checkbox"/> Welded <input type="checkbox"/> Surface <u>12</u> in. RMP <input type="checkbox"/> PVC <input type="checkbox"/> Weight <u>34</u> lbs./ft. Dia. <u>16</u> in. to <u>125</u> ft. depth Wall Thickness: inches or Dia. <u>in.</u> to <u>ft.</u> depth gage No. <u>3/4</u> "	
Clay Red				7		12		10. Screen: Manufacturer's name <u>Aurora Tile Co.</u> Type <u>TRANSITE</u> Dia. <u>16</u> " I.O. Slot/gauze <u>1/8</u> " Length <u>39</u> Set between <u>86</u> ft. and <u>125</u> ft. ft. and <u>ft.</u> Gravel pack? <u>yes</u> Size range of material <u>1/4</u> "	
Clay - Silty				12		33		11. Static water level: <u>38</u> ft. below land surface Date <u>8-1-76</u> mo./day/yr.	
SAND - Fine				33		51		12. Pumping level below land surfaces: <u>71</u> ft. after <u>6</u> hrs. pumping <u>800</u> g.p.m. ft. after <u>hrs.</u> pumping <u>g.p.m.</u> Estimated maximum yield <u>1000</u> g.p.m.	
(Low) SAND - med to fine				51		88		13. Water sample submitted: <u>Yes</u> <input checked="" type="checkbox"/> No Date <u>mo./day/yr.</u>	
Clay - Gray				88		90		14. Well head completion: <input type="checkbox"/> Pitless adapter <u>12</u> inches above grade	
Sand - medium to coarse				90		97		15. Well grouted? <u>Yes</u> <u>Puddled clay</u> With: <input type="checkbox"/> Neat cement <input type="checkbox"/> Bentonite <input type="checkbox"/> Concrete Depth: From <u>0</u> ft. to <u>10</u> ft.	
Clay				97		98		16. Nearest source of possible contamination: ft. <u>1200</u> Direction <u>W</u> Type <u>well</u> Well disinfected upon completion? <input type="checkbox"/> Yes <input checked="" type="checkbox"/> No	
Clay - Buff				112		117		17. Pump: <u>Not installed</u> Manufacturer's name <u>Western Hard Rock</u> Model number <u>600</u> HP <u>Volts</u> Length of drop pipe <u>110</u> ft. capacity <u>800</u> g.p.m. Type: <input type="checkbox"/> Submersible <input checked="" type="checkbox"/> Turbine <input type="checkbox"/> Jet <input type="checkbox"/> Reciprocating <input type="checkbox"/> Centrifugal <input type="checkbox"/> Other	
SAND - med. to coarse				117		124		20. Water well contractor's certification: This well was drilled under my jurisdiction and this report is true to the best of my knowledge and belief. <u>Peterson Drilling Inc. 138A</u> Business name License No. Address <u>Box 150 Lindsborg, KS</u> Signed <u>William Peterson</u> Date <u>1-7-77</u> Authorized representative	
SHALE Green				124		125			
(Use a second sheet if needed)									
18. Elevation:		19. Remarks:		20. Water well contractor's certification: This well was drilled under my jurisdiction and this report is true to the best of my knowledge and belief. <u>Peterson Drilling Inc. 138A</u> Business name License No. Address <u>Box 150 Lindsborg, KS</u> Signed <u>William Peterson</u> Date <u>1-7-77</u> Authorized representative					
Topography: <input type="checkbox"/> Hill <input type="checkbox"/> Slope <input checked="" type="checkbox"/> Upland <input type="checkbox"/> Valley									