

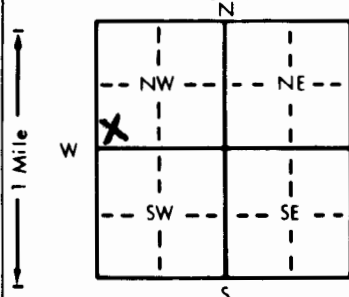
1 LOCATION OF WATER WELL: County: <u>Moprherson</u> Fraction <u>Sw 1/4 Sw 1/4 NW 1/4</u> Section Number <u>36</u> Township Number <u>T 21 S</u> Range Number <u>R 3 E</u>
--

Distance and direction from nearest town or city street address of well if located within city?

5 W 1/2 S Moundridge

2 WATER WELL OWNER: <u>Galen Waltnen</u> RR#, St. Address, Box #: <u>BRI Box 49</u> City, State, ZIP Code: <u>Moundridge, KS. 67104</u>	Board of Agriculture, Division of Water Resources Application Number:
---	--

3 LOCATE WELL'S LOCATION WITH AN "X" IN SECTION BOX:	4 DEPTH OF COMPLETED WELL: <u>110</u> ft. ELEVATION:
--	--


WELL WATER TO BE USED AS: 5 Public water supply 8 Air conditioning 11 Injection well

1 Domestic 3 Feedlot 6 Oil field water supply 9 Dewatering 12 Other (Specify below)

2 Irrigation 4 Industrial 7 Lawn and garden only 10 Monitoring well

Was a chemical/bacteriological sample submitted to Department? Yes X No X If yes, mo/day/yr sample was sub-mitted Water Well Disinfected? Yes X No X

5 TYPE OF BLANK CASING USED:	5 Wrought iron	8 Concrete tile	CASING JOINTS: Glued <u>X</u> Clamped
------------------------------	----------------	-----------------	---------------------------------------

1 Steel 3 RMP (SR) 6 Asbestos-Cement 9 Other (specify below) Welded

2 PVC 4 ABS 7 Fiberglass Threaded

Blank casing diameter 5 in. to 98 ft. Dia 12 in. to 160 ft. Dia 12 in. to 160 ft.Casing height above land surface 12 in. weight 160 lbs./ft. Wall thickness or gauge No. 214

TYPE OF SCREEN OR PERFORATION MATERIAL:	7 PVC	10 Asbestos-cement
---	-------	--------------------

1 Steel 3 Stainless steel 5 Fiberglass 8 RMP (SR) 11 Other (specify)

2 Brass 4 Galvanized steel 6 Concrete tile 9 ABS 12 None used (open hole)

SCREEN OR PERFORATION OPENINGS ARE:	5 Gauzed wrapped	8 Saw cut	11 None (open hole)
-------------------------------------	------------------	-----------	---------------------

1 Continuous slot 3 Mill slot 6 Wire wrapped 9 Drilled holes

2 Louvered shutter 4 Key punched 7 Torch cut 10 Other (specify)

SCREEN-PERFORATED INTERVALS:	From <u>98</u> ft. to <u>110</u> ft.	From <u>110</u> ft. to <u>110</u> ft.
------------------------------	--------------------------------------	---------------------------------------


6 GROUT MATERIAL:	1 Neat cement	2 Cement grout	3 Bentonite	4 Other
-------------------	---------------	----------------	-------------	---------

Grout Intervals: From 0 ft. to 24 ft. From 24 ft. to 110 ft. From 110 ft. to 110 ft.

What is the nearest source of possible contamination:

1 Septic tank 4 Lateral lines 7 Pit privy 10 Livestock pens 14 Abandoned water well

2 Sewer lines 5 Cess pool 8 Sewage lagoon 11 Fuel storage 15 Oil well/Gas well

3 Watertight sewer lines 6 Seepage pit 9 Feedyard 12 Fertilizer storage 16 Other (specify below)

13 Insecticide storage

Direction from well? <u>N</u>	How many feet? <u>75+</u>
-------------------------------	---------------------------

FROM	TO	LITHOLOGIC LOG	FROM	TO	PLUGGING INTERVALS
------	----	----------------	------	----	--------------------

0 35 Clay35 42 fine Sand42 65 Clay mixed Sand65 110 medium Sand