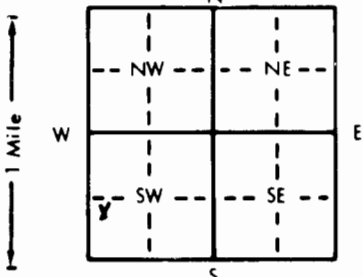


1 LOCATION OF WATER WELL:	Fraction	Section Number	Township Number	Range Number
County: McPherson	NW 1/4 SW 1/4 SW 1/4	29	T 21 S	R 3 E

Distance and direction from nearest town or city street address of well if located within city?

3 miles South, 5 miles East, 1/2 North of Inman

2 WATER WELL OWNER: Virgil Unruh	Board of Agriculture, Division of Water Resources
RR#, St. Address, Box #: 139 13th Avenue	Application Number: 28964
City, State, ZIP Code: Inman, KS 67546	

3 LOCATE WELL'S LOCATION WITH AN "X" IN SECTION BOX:	4 DEPTH OF COMPLETED WELL: 130 ft. ELEVATION:
	Depth(s) Groundwater Encountered 1. ft. 2. ft. 3. ft.
	WELL'S STATIC WATER LEVEL . . . 36 . . . ft. below land surface measured on mo/day/yr
	Pump test data: Well water was ft. after hours pumping gpm
	Est. Yield gpm: Well water was ft. after hours pumping gpm
	Bore Hole Diameter . . . 28 . . . in. to . . . 130 . . . ft., and in. to ft.
	WELL WATER TO BE USED AS: 5 Public water supply 8 Air conditioning 11 Injection well
	1 Domestic 3 Feedlot 6 Oil field water supply 9 Dewatering 12 Other (Specify below)
	2 Irrigation 4 Industrial 7 Lawn and garden only 10 Monitoring well
	Was a chemical/bacteriological sample submitted to Department? Yes No . . . X . . . ; If yes, mo/day/yr sample was submitted
	Water Well Disinfected? Yes X No

5 TYPE OF BLANK CASING USED:	5 Wrought iron	8 Concrete tile	CASING JOINTS: Glued X Clamped
1 Steel	3 RMP (SR)	6 Asbestos-Cement	9 Other (specify below)
2 PVC	4 ABS	7 Fiberglass	10 Asbestos-cement
Blank casing diameter . . . 16 . . . in. to . . . 80 . . . ft., Dia in. to ft., Dia in. to ft.			
Casing height above land surface . . . 12 . . . in., weight . . . SCH40 . . . lbs./ft. Wall thickness or gauge No. . . 500 . . .			
TYPE OF SCREEN OR PERFORATION MATERIAL:	7 PVC	10 Asbestos-cement	
1 Steel	3 Stainless steel	5 Fiberglass	8 RMP (SR)
2 Brass	4 Galvanized steel	6 Concrete tile	9 ABS
11 Other (specify)			
SCREEN OR PERFORATION OPENINGS ARE:	5 Gauzed wrapped	8 Saw cut	11 None (open hole)
1 Continuous slot	3 Mill slot	6 Wire wrapped	9 Drilled holes
2 Louvered shutter	4 Key punched	7 Torch cut	10 Other (specify)
SCREEN-PERFORATED INTERVALS: From . . . 80 . . . ft. to . . . 130 . . . ft., From ft. to ft.			
GRAVEL PACK INTERVALS: From . . . 130 . . . ft. to . . . 20 . . . ft., From ft. to ft.			

6 GROUT MATERIAL:	1 Neat cement	2 Cement grout	3 Bentonite	4 Other
Grout Intervals: From . . . 20 . . . ft. to . . . 0 . . . ft., From ft. to ft., From ft. to ft.				
What is the nearest source of possible contamination:	10 Livestock pens	14 Abandoned water well		
1 Septic tank	4 Lateral lines	7 Pit privy	11 Fuel storage	15 Oil well/Gas well
2 Sewer lines	5 Cess pool	8 Sewage lagoon	12 Fertilizer storage	16 Other (specify below)
3 Watertight sewer lines	6 Seepage pit	9 Feedyard	13 Insecticide storage	
Direction from well? East			How many feet? 15'	

FROM	TO	LITHOLOGIC LOG	FROM	TO	PLUGGING INTERVALS
0	2	Top Soil			
2	5	Brown Clay			
5	10	Gray Clay			
10	25	Clay			
25	50	Yellow Clay			
50	60	Sandy Clay Mixture			
60	75	Fine Sand			
75	80	Sand & Clay			
80	90	Sand			
90	105	Clay			
105	130	Sand			

7 CONTRACTOR'S OR LANDOWNER'S CERTIFICATION: This water well was (1) constructed, (2) reconstructed, or (3) plugged under my jurisdiction and was completed on (mo/day/year) 6-20-98 and this record is true to the best of my knowledge and belief. Kansas Water Well Contractor's License No. 134 This Water Well Record was completed on (mo/day/yr) 6-22-98 under the business name of Rosencrantz-Bemis Ent. Inc. by (signature) Alicia Coffey
