

HOME PHONE
MOHAWK 2-3991

D. J. DARLING DRILLING CO.

1211 WEST FOURTH
HUTCHINSON, KANSAS

OFFICE PHONE
MOHAWK 2-7901

LOG OF TEST WELL


DALE JEWETT RFD #4
HUTCHINSON.

Date of Test 9-11-62

Customer INDEPENDENT LEASE MANAGEMENT Address 302 UNION CENTER, WICHITA

Location SW-SW-SE SEC 35-21-3W
MC PHERSON, CO. GREIBEL 1

Static Water Level 35

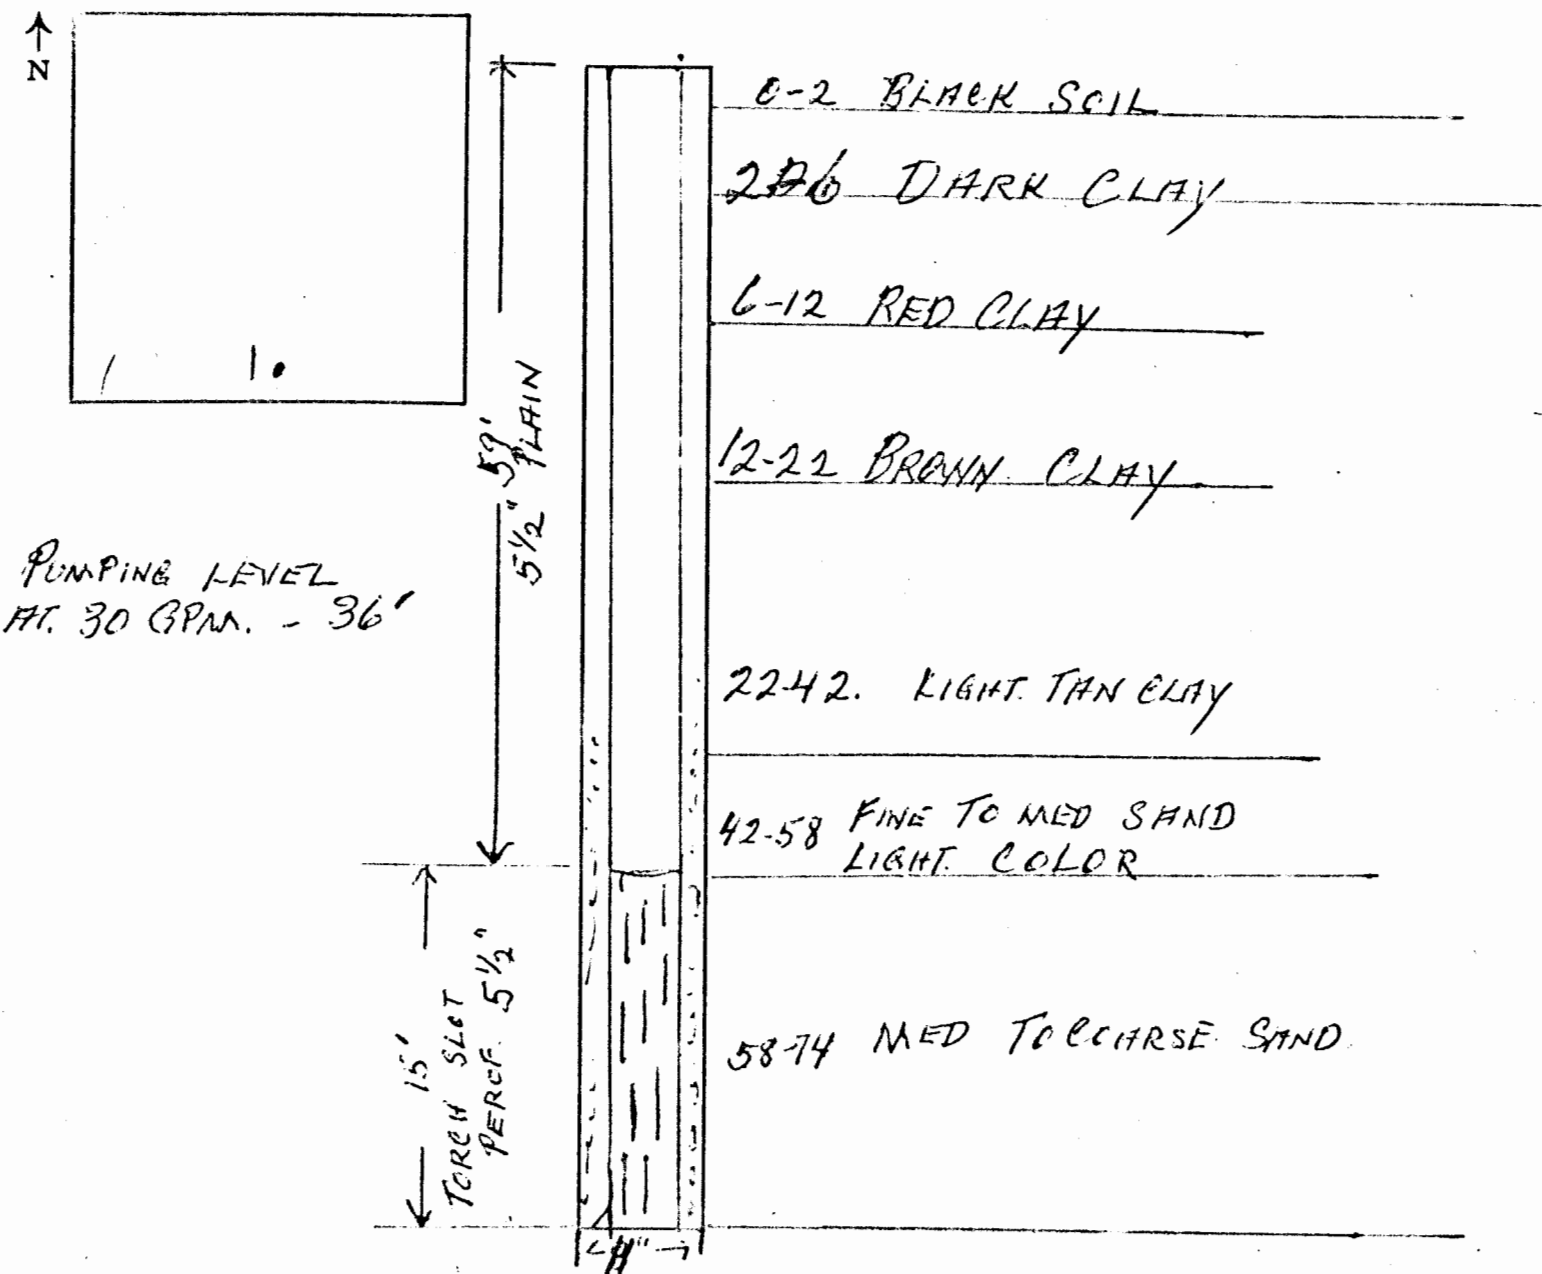

Water Test _____

Darling
D. J. DARLING DRILLING CO.