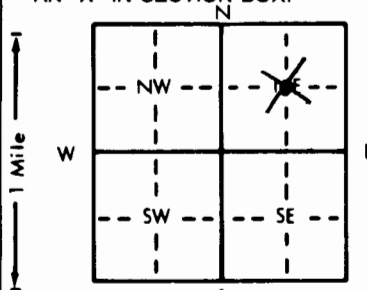


1 LOCATION OF WATER WELL:	Fraction	Section Number	Township Number	Range Number
County: McPherson 059	Near 1/4 Center 1/4 NE 1/4	26	T 21 S	R 3

Distance and direction from nearest town or city street address of well if located within city?

7 miles West of Moundridge, KS

2 WATER WELL OWNER: Robert L. Kaufman	Board of Agriculture, Division of Water Resources
RR#, St. Address, Box #: Rt 1, Box 173	Application Number:
City, State, ZIP Code: McPherson, KS 67460	

3 LOCATE WELL'S LOCATION WITH AN "X" IN SECTION BOX:	4 DEPTH OF COMPLETED WELL 122 ft. ELEVATION:
	Depth(s) Groundwater Encountered 1. 40 ft. 2. ft. 3. ft.
	WELL'S STATIC WATER LEVEL 40 ft. below land surface measured on mo/day/yr 1-24-95
	Pump test data: Well water was ft. after hours pumping gpm
	Est. Yield 800-1000 gpm: Well water was ft. after hours pumping gpm
	Bore Hole Diameter 30 in. to 123 ft. and in. to ft.
	WELL WATER TO BE USED AS:
	1 Domestic 3 Feedlot 6 Oil field water supply 9 Dewatering 12 Other (Specify below)
	2 Irrigation 4 Industrial 7 Lawn and garden only 10 Monitoring well
	Was a chemical/bacteriological sample submitted to Department? Yes No X If yes, mo/day/yr sample was submitted
	Water Well Disinfected? Yes X No

5 TYPE OF BLANK CASING USED:	5 Wrought iron	8 Concrete tile	CASING JOINTS: Glued X Clamped
1 Steel	3 RMP (SR)	6 Asbestos-Cement	9 Other (specify below)
2 PVC	4 ABS	7 Fiberglass	10 Asbestos-cement
Blank casing diameter 1.6 in. to 82 ft. Dia			11 Other (specify)
Casing height above land surface 12 in. weight 1.6 15 lbs./ft. Wall thickness or gauge No. 500			12 None used (open hole)
TYPE OF SCREEN OR PERFORATION MATERIAL:			
1 Steel	3 Stainless steel	5 Fiberglass	8 RMP (SR)
2 Brass	4 Galvanized steel	6 Concrete tile	9 ABS
SCREEN OR PERFORATION OPENINGS ARE:			
1 Continuous slot	3 Mill slot	5 Gauzed wrapped	8 Saw cut
2 Louvered shutter	4 Key punched	6 Wire wrapped	9 Drilled holes
SCREEN-PERFORATED INTERVALS:			
From 82 ft. to 122 ft.			
GRAVEL PACK INTERVALS:			
From 20 ft. to 122 ft.			

6 GROUT MATERIAL:	1 Neat cement	2 Cement grout	3 Bentonite	4 Other
Grout Intervals: From 0 ft. to 20 ft.				
What is the nearest source of possible contamination: None within 1/4 mile				
1 Septic tank	4 Lateral lines	7 Pit privy	11 Fuel storage	14 Abandoned water well
2 Sewer lines	5 Cess pool	8 Sewage lagoon	12 Fertilizer storage	15 Oil well/Gas well
3 Watertight sewer lines	6 Seepage pit	9 Feedyard	13 Insecticide storage	16 Other (specify below)
Direction from well?				

FROM	TO	LITHOLOGIC LOG	FROM	TO	PLUGGING INTERVALS
0	5	Top Soil			
5	19	Brown Clay			
19	27	Tan Clay			
27	50	Tan Sandy Clay			
50	58	Fine Sand & Clay			
58	68	Medium Sand & Clay Streaks			
68	79	Medium to Course Sand			
79	83	Tan Clay			
83	95	Medium to Course Sand			
95	98	Brown Clay			
98	121	Medium Sand			
121	123	Red Clay			
123		Red Shale			

7 CONTRACTOR'S OR LANDOWNER'S CERTIFICATION: This water well was (1) constructed, (2) reconstructed, or (3) plugged under my jurisdiction and was completed on (mo/day/year) 1-24-95 and this record is true to the best of my knowledge and belief. Kansas Water Well Contractor's License No. 138 This Water Well Record was completed on (mo/day/yr) 2-15-95 under the business name of Peterson Irrigation Inc. by (signature) Mike Peterson
--