


1] LOCATION OF WATER WELL: County: Finney Fraction SE 1/4 SE 1/4 SW 1/4 Section Number 32 Township Number T 21 S Range Number 30 E/W

Distance and direction from nearest town or city street address of well if located within city? 11 1/2 miles east of Garden City on US 156, 8 miles north on Menenite Road, 1 1/2 miles east

2] WATER WELL OWNER: Jerry Bolding 14135 East Meeker Road Garden City, Ks. 67864 Board of Agriculture, Division of Water Resources Application Number:

3] LOCATE WELL'S LOCATION WITH AN "X" IN SECTION BOX:

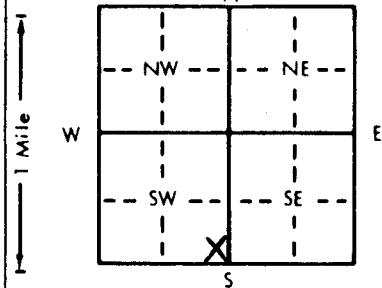

4] DEPTH OF COMPLETED WELL: 79 ft. ELEVATION: NA. WELL'S STATIC WATER LEVEL: 56.29 ft. below land surface. Pump test data: Well water was ... ft. after ... hours pumping ... gpm. Est. Yield ... gpm: Well water was ... ft. after ... hours pumping ... gpm. Bore Hole Diameter: 10 in. to 85 in. and ... in. to ... ft. WELL WATER TO BE USED AS: 5 Public water supply, 8 Air conditioning, 11 Injection well, 1 Domestic, 3 Feedlot, 6 Oil field water supply, 9 Dewatering, 12 Other (Specify below), 2 Irrigation, 4 Industrial, 7 Lawn and garden only, 10 Monitoring well. Was a chemical/bacteriological sample submitted to Department? Yes ... No X. Water Well Disinfected? Yes ... No X.

5] TYPE OF BLANK CASING USED: 1 Steel, 2 PVC, 3 RMP (SR), 4 ABS, 5 Wrought iron, 6 Asbestos-Cement, 7 Fiberglass, 8 Concrete tile, 9 Other (specify below), CASING JOINTS: Glued, Clamped, Welded, Threaded X. Blank casing diameter: 4 in. to 49 in., Dia. in. to ... ft., Dia. in. to ... ft. Casing height above land surface: 24 in., weight ... lbs./ft. Wall thickness or gauge No. sch. 40.

TYPE OF SCREEN OR PERFORATION MATERIAL: 1 Steel, 2 Brass, 3 Stainless steel, 4 Galvanized steel, 5 Fiberglass, 6 Concrete tile, 7 PVC, 8 RMP (SR), 9 ABS, 10 Asbestos-cement, 11 Other (specify), 12 None used (open hole).

SCREEN OR PERFORATION OPENINGS ARE: 1 Continuous slot, 2 Louvered shutter, 3 Mill slot, 4 Key punched, 5 Gauzed wrapped, 6 Wire wrapped, 7 Torch cut, 8 Saw cut, 9 Drilled holes, 10 Other (specify), 11 None (open hole).

SCREEN-PERFORATED INTERVALS: From 49 ft. to 79 ft., From ... ft. to ... ft., From ... ft. to ... ft. GRAVEL PACK INTERVALS: From 42 ft. to 85 ft., From ... ft. to ... ft., From ... ft. to ... ft.

6] GROUT MATERIAL: 1 Neat cement, 2 Cement grout, 3 Bentonite, 4 Other. Grout Intervals: From 8 ft. to 42 ft., From 0 ft. to 8 ft., From ... ft. to ... ft.

What is the nearest source of possible contamination: 1 Septic tank, 2 Sewer lines, 3 Watertight sewer lines, 4 Lateral lines, 5 Cess pool, 6 Seepage pit, 7 Pit privy, 8 Sewage lagoon, 9 Feedyard, 10 Livestock pens, 11 Fuel storage, 12 Fertilizer storage, 13 Insecticide storage, 14 Abandoned water well, 15 Oil well/Gas well, 16 Other (specify below). Direction from well? west How many feet? 5

Table with columns: FROM, TO, LITHOLOGIC LOG, FROM, TO, PLUGGING INTERVALS. Rows show depth intervals and lithology: 0-33 slty cly, lt-dk brn; 33-41 slty cly, lt gy-white; 41-60 slty cly, tan-brn; 60-63 snd, lt-med brn; 63-85 cly, lt brn. MW6-above ground cover.

7] CONTRACTOR'S OR LANDOWNER'S CERTIFICATION: This water well was (1) constructed, (2) reconstructed, or (3) plugged under my jurisdiction and was completed on (mo/day/year) 12-14-93 and this record is true to the best of my knowledge and belief. Kansas Water Well Contractor's License No. 527 This Water Well Record was completed on (mo/day/yr) 03-11-94 under the business name of GeoCore Services, Inc. by (signature) Dale Robb