


1 LOCATION OF WATER WELL: Fraction Section Number Township Number Range Number
 COUNTY: 028 FINNEY NC *S 1/2* S 1/2 NE 1/4 06 T 21 S R 32 W

Distance and direction from nearest town or city street address of well if located within city?
 FROM FRIEND; APPX 2 MILES EAST

2 WATER WELL OWNER: DR. JOSHUA GOODEN Board of Agriculture, Division of Water Resources
 RR#, St. Address, Box # : 503 CENTER Application Number: 11,861
 City, State, ZIP code : OAKLEY, KS 67748-1719

3 LOCATE WELL'S LOCATION WITH AN "X" IN SECTION BOX:

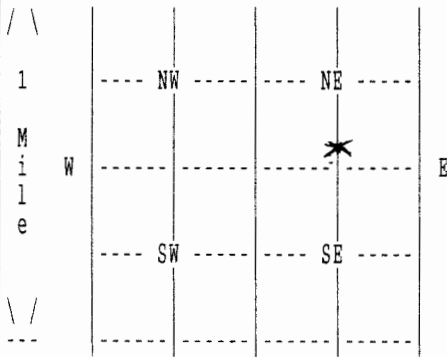

4 DEPTH OF COMPLETED WELL 191 ELEVATION: 0
 Depth(s) Groundwater Encountered 1. 0 ft. 2. 0 ft. 3. 0 ft.
 WELL'S STATIC WATER LEVEL 117 ft. below land surface measured on mo/day/yr 04/26/05
 Pump test data: Well water was 150 ft. after 4 hours pumping 700 gpm
 Estimated Yield 0 gpm: Well water was 0 ft. after 0 hours pumping 0 gpm
 Bore Hole Diameter 24 in. to 191 ft., and in. to 0 ft.
 WELL WATER TO BE USED AS: 02 IRRIGATION
 Was a chemical/bacteriological sample submitted to department? No ;
 If yes, mo/day/yr sample was submitted Water well disinfected? Yes

5 TYPE OF BLANK CASING USED: 01 STEEL CASING JOINTS: WELDED
 Blank casing diameter 16 in. to 191 ft., Dia in. to 0 ft., Dia in. to 0 ft.
 Casing height above land surface 12 in., weight 37 lbs/ft. Wall thickness or gauge No. .219
 TYPE OF SCREEN OR PERFORATION MATERIAL: 01 STEEL
 SCREEN OR PERFORATION OPENINGS ARE: 01 CONT. SLOT

SCREEN PERFORATED INTERVALS: From 131 ft. to 171 ft., From 0 ft. to 0 ft.
 From 0 ft. to 0 ft., From 0 ft. to 0 ft.
 GRAVEL PACK INTERVALS: From 20 ft. to 191 ft., From 0 ft. to 0 ft.
 From 0 ft. to 0 ft., From 0 ft. to 0 ft.

6 GROUT MATERIAL 03 BENTONITE
 Grout Intervals: From 0 ft. to 20 ft., From 0 ft. to 0 ft., From 0 ft. to 0 ft.
 What is the nearest source of possible contamination: NONE OBSERVED
 Direction from well? How many feet? 0

FROM	TO	LITHOLOGIC LOG	FROM	TO	PLUGGING INTERVALS
0	2	02 SILT			
2	7	01 CLAY			
7	20	07 FINE SAND 08 MEDIUM SAND			
20	59	01 CLAY			
59	62	07 FINE SAND 01 CLAY			
62	79	08 MEDIUM SAND 09 COARSE SAND 01 CLAY			
79	102	01 CLAY			
102	116	08 MEDIUM SAND 09 COARSE SAND 13 FINE GRAVEL			
116	122	08 MEDIUM SAND 09 COARSE SAND 01 CLAY			
122	162	08 MEDIUM SAND 09 COARSE SAND 13 FINE GRAVEL			

7 CONTRACTOR'S OR LANDOWNER'S CERTIFICATION: This water well was Constructed under my jurisdiction and was completed on (mo/day/year) 04/22/05 and this record is true to the best of my knowledge and belief. Kansas Water Well Contractor's License No. 145 This Water Well Record was completed on (mo/day/yr) 06/15/05 under the business name of HENKLE DRILLING & SUPPLY by (signature)

1 LOCATION OF WATER WELL: COUNTY: 028 FINNEY	Fraction NC 1/4 S 1/2 1/4 NE 1/4	Section Number 06	Township Number T 21 S	Range Number R 32 W
---	-------------------------------------	----------------------	---------------------------	------------------------

2 WATER WELL OWNER: DR. JOSHUA GOODEN
 RR#, St. Address, Box # : 503 CENTER Board of Agriculture, Division of Water Resources
 City, State, ZIP code : OAKLEY, KS 67748-1719 Application Number: 11,861

FROM	TO	LITHOLOGIC LOG
162	171	09 COARSE SAND 11 GRAVEL
171	181	31 CALICHE
181	182	19 SHALE

7 CONTRACTOR'S OR LANDOWNER'S CERTIFICATION: This water well was Constructed under my jurisdiction and was completed on (mo/day/year) 04/22/05 and this record is true to the best of my knowledge and belief. Kansas Water Well Contractor's License No. 145 This Water Well Record was completed on (mo/day/yr) 06/15/05 under the business name of HENKLE DRILLING & SUPPLY by (signature) *Brian J. Kucharski*