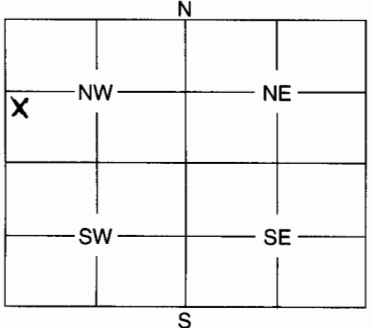


1 LOCATION OF WATER WELL: County: <u>Finney</u>	Fraction <u>NW SW NW</u> <u>¼ ¼ ¼</u>	Section Number <u>9</u>	Township Number <u>21</u>	Range Number <u>32</u> <span style="float:right; border: 1px solid black; border-radius: 50%; padding: 2px;">EW</span>
--	---	----------------------------	------------------------------	---

Distance and direction from nearest town or city street address of well if located within city?

2 WATER WELL OWNER: RR #, St. Address, Box #: City, State, ZIP Code :	<u>Chuck Robison</u> <u>11450 N. Hwy 83</u> <u>Garden City, KS 67846</u>	Board of Agriculture, Division of Water Resources Application Number:
---	--	--

3 MARK WELL'S LOCATION WITH AN "X" IN SECTION BOX:  <div style="text-align: center;">  </div>	4 DEPTH OF WELL ..... <u>116</u> ..... ft.  WELL'S STATIC WATER LEVEL ..... <u>107</u> ..... ft.  WELL WAS USED AS: <table style="width:100%; border: none;"> <tr> <td style="width:33%;">1 Domestic</td> <td style="width:33%;">5 Public Water Supply</td> <td style="width:33%;">9 Dewatering</td> </tr> <tr> <td><input checked="" type="checkbox"/> Irrigation</td> <td>6 Oil Field Water Supply</td> <td>10 Monitoring Well</td> </tr> <tr> <td>3 Feedlot</td> <td>7 Domestic (Lawn &amp; Garden)</td> <td>11 Injection Well</td> </tr> <tr> <td>4 Industrial</td> <td>8 Air Conditioning</td> <td>12 Other .....</td> </tr> </table> <p>Was a chemical / bacteriological sample submitted to Department? Yes ..... No <input checked="" type="checkbox"/> .....</p> <p>If yes, mo/day/yr sample was submitted .....</p> <p>Water Well Disinfected: Yes <input checked="" type="checkbox"/> .

5 TYPE OF BLANK CASING USED:	<input checked="" type="checkbox"/> Steel    3 RMP (SR)    5 Wrought    7 Fiberglass    9 Other (Specify below) 2 PVC    4 ABS    6 Asbestos-Cement    8 Concrete Tile
Blank casing diameter ... <u>16</u> ... in.	Was casing pulled? Yes ..... No ..... If yes, how much .....
Casing height above or below land surface ... <u>3'</u> ... in.	

6 GROUT PLUG MATERIAL:	1 Neat cement    2 Cement grout <input checked="" type="checkbox"/> Bentonite    4 Other .....
Grout Plug Intervals:	From ..... <u>3</u> ..... ft. to ..... <u>6</u> ..... ft., From ..... ft. to ..... ft., From ..... to ..... ft.
What is the nearest source of possible contamination: <u>none</u>	
1 Septic tank    6 Seepage pit    11 Fuel storage    16 Other (specify below) 2 Sewer lines    7 Pit privy    12 Fertilizer storage 3 Watertight sewer lines    8 Sewage lagoon    13 Insecticide storage 4 Lateral lines    9 Feedyard    14 Abandoned water well 5 Cess pool    10 Livestock pens    15 Oil well/Gas well	
Direction from well? .....	How many feet? .....

FROM	TO	PLUGGING MATERIALS
100	116	<u>1 yd. Washed sand + gravel</u>
6	100	<u>5 yds washed sand, clay + bentonite Mixed</u>
3	6	<u>400 lbs. bentonite chips</u>
0	3	<u>top soil</u>

7 CONTRACTOR'S OF LANDOWNER'S CERTIFICATION:	This water well was plugged under my jurisdiction and was completed on (mo/day/year) ..... <u>8-2-05</u> ..... and this record is true to the best of my knowledge and belief. Kansas Water Well Contractor's License No. .... <u>532</u> ..... This Water Well Record was completed on (mo/day/year) ..... <u>8-17-05</u> ..... under the business name of ..... <u>Midwest Well + Pump Inc.</u> ..... by (signature) ..... <u>Kevin Sankup</u> .....
--	--

INSTRUCTIONS: Use typewriter or ball point pen. Please press firmly and print clearly. Please fill in blanks, underline or circle the correct answers. Send top three copies to Kansas Department of Health and Environment, Bureau of Water, Geology Section, 1000 SW Jackson St., Ste. 420, Topeka, Kansas 66612-1367. Telephone: 785/296-5522. Send one to Water Well Owner and retain one for your records.