

# WATER WELL PLUGGING RECORD Form WWC-5P

KSA 82a-1212

ID NO.

**1 LOCATION OF WATER WELL:** Fraction S 1/4 W 1/4 NE 1/4 SE 1/4 Section Number 2 Township Number T 21 S Range Number 33 ☐ E ☒ W

Street/Rural Address of Well Location: if unknown, distance & direction from nearest town or intersection: If at owner's address, check here ☒

## Global Positioning Systems (GPS) information:


Latitude: \_\_\_\_\_ (in decimal degrees)  
Longitude: \_\_\_\_\_ (in decimal degrees)  
Elevation: \_\_\_\_\_

Horizontal Datum: ☐ WGS84, ☐ NAD83, ☐ NAD27  
Collection Method: \_\_\_\_\_

**2 WATER WELL OWNER:** Oran Tankersley  
RR#, St. Address, Box #: 20960 Anderson Rd.  
City, State ZIP Code: Garden City, KS 67846

☐ GPS unit (Make/Model: \_\_\_\_\_)  
☐ Digital Map/Photo, ☐ Topographic Map, ☐ Land Survey  
Est. Accuracy: ☐ < 3 m, ☐ 3-5 m, ☐ 5-15 m, ☐ > 15 m

## 3 MARK WELL'S LOCATION WITH AN "X" IN SECTION BOX:

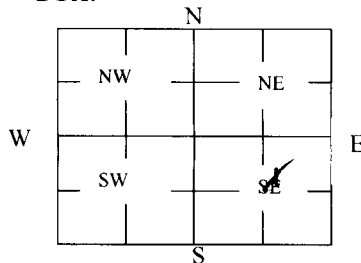

## 4 DEPTH OF WELL 96 ft.

WELL'S STATIC WATER LEVEL none ft

WELL WAS USED AS:

- ☒ Domestic ☐ Public Water Supply ☐ Dewatering  
☐ Irrigation ☐ Oil Field Water Supply ☐ Monitoring  
☐ Feedlot ☐ Domestic (Lawn & Garden) ☐ Injection Well  
☐ Industrial ☐ Air Conditioning ☐ Other \_\_\_\_\_

Was a chemical/bacteriological sample submitted to Department? Yes ☐ No ☒

## 5 TYPE OF BLANK CASING USED:

- ☒ Steel ☐ RMP (SR) ☐ Wrought ☐ Fiberglass ☐ Other (Specify below)  
☐ PVC ☐ ABS ☐ Asbestos-Cement ☐ Concrete Tile

Blank casing diameter 5 in. Was casing pulled? Yes ☐ No ☒ If yes, how much \_\_\_\_\_  
Casing height above or below land surface 48 in.

## 6 GROUT PLUG MATERIAL: ☐ Neat cement ☐ Cement grout ☒ Bentonite ☐ Other \_\_\_\_\_

Grout Plug Intervals: From 4 ft. to 24 ft., From \_\_\_\_\_ ft. to \_\_\_\_\_ ft., From \_\_\_\_\_ ft. to \_\_\_\_\_ ft.

What is the nearest source of possible contamination:

- ☐ Septic tank ☐ Seepage pit ☐ Fuel storage ☐ Other (specify below)  
☐ Sewer lines ☐ Pit privy ☐ Fertilizer storage  
☐ Watertight sewer lines ☐ Sewage lagoon ☐ Insecticide storage  
☒ Lateral lines ☐ Feedyard ☐ Abandoned water well Direction from well? North West  
☐ Cess pool ☐ Livestock pens ☐ Oil well/Gas well How many feet? 145'

FROM	TO	PLUGGING MATERIALS	FROM	TO	PLUGGING MATERIALS
0	4	Top Soil			
4	24	Bentonite Chips			
24	96	Sand, Gravel, Bentonite			

**7 CONTRACTOR'S OR LANDOWNER'S CERTIFICATION:** This water well was plugged under my jurisdiction and was completed on (mo/day/year) 6-4-20 and this record is true to the best of my knowledge and belief. Kansas Water Well Contractor's License No. 532. This Water Well Record was completed on (mo/day/year) 6-16-20 under the business name of Midwest Well & Pump Inc. by (signature) \_\_\_\_\_

Send one white copy to Kansas Department of Health & Environment, Geology Section, 1000 SW Jackson Street, Ste. 420, Topeka, KS 66612-1367. Send one copy to WATER WELL OWNER and retain one for your records.

Visit us at <http://www.kdheks.gov/waterwell/index.html> Telephone 785-296-5524.

KSA82a-1212

Revised 1/20/2015