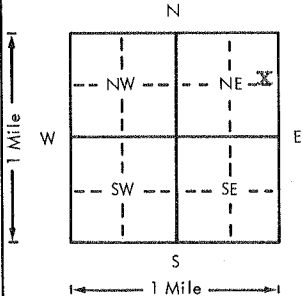


USE TYPEWRITER OR BALL
POINT PEN-PRESS FIRMLY,
PRINT CLEARLY.

WATER WELL RECORD
KSA 82a-1201-1215

Kansas Department of Health and
Environment-Division of Environment
(Water well Contractors)
Topeka, Kansas 66620

1. Location of well:		County Kearney	Fraction SE 1/4 NE 1/4 NE 1/4	Section number 8	Township number T 21 S R 36 E/W	Range number
2. Distance and direction from nearest town or city: 21 mi. N and 1 mi. W of Lakin, Ks.		3. Owner of well: Art Joiner R.R. or street: North Star Rte. City, state, zip code: Leoti, Ks. 67861				
4. Locate with "X" in section below:		Sketch map:		6. Bore hole dia. 10 in. Completion date 12/16/76 Well depth 160 ft.		
				7. <input checked="" type="checkbox"/> Cable tool <input checked="" type="checkbox"/> Rotary <input type="checkbox"/> Driven <input type="checkbox"/> Dug <input type="checkbox"/> Hollow rod <input type="checkbox"/> Jetted <input type="checkbox"/> Bored <input type="checkbox"/> Reverse rotary		
5. Type and color of material		From	To	8. Use: <input checked="" type="checkbox"/> Domestic <input type="checkbox"/> Public supply <input type="checkbox"/> Industry <input type="checkbox"/> Irrigation <input type="checkbox"/> Air conditioning <input type="checkbox"/> Stock <input type="checkbox"/> Lawn <input type="checkbox"/> Oil field water <input type="checkbox"/> Other		
clay		0	20	9. Casing: Material PVC Height: Above or below Threaded <input type="checkbox"/> Welded <input checked="" type="checkbox"/> Surface 18 in. RMP <input type="checkbox"/> PVC <input type="checkbox"/> Weight <input type="checkbox"/> lbs./ft. Dia. 5 in. to 160 ft. depth Wall Thickness: inches or Dia. <input type="checkbox"/> in. to <input type="checkbox"/> ft. depth Gage No. Sch 40		
sand & clay mixed		20	40	10. Screen: Manufacturer's name Jesse - Lowell Type <input type="checkbox"/> Dia. 5" Slot/gauze 1/16" Length 50' Set between 110 ft. and 160 ft. Gravel pack? yes Size range of material 1/16"		
sand & gravel		40	60	11. Static water level: <input type="checkbox"/> mo./day/yr. 112 ft. below land surface Date 9/18/76		
medium sand		60	80	12. Pumping level below land surfaces: 120 ft. after 2 hrs. pumping 5 g.p.m. <input type="checkbox"/> ft. after <input type="checkbox"/> hrs. pumping <input type="checkbox"/> g.p.m. Estimated maximum yield 5 g.p.m.		
medium sand, gravel		80	110	13. Water sample submitted: <input type="checkbox"/> mo./day/yr. <input type="checkbox"/> Yes <input checked="" type="checkbox"/> No Date <input type="checkbox"/>		
gyp rock		110	140	14. Well head completion: <input checked="" type="checkbox"/> Pitless adapter 18 inches above grade		
hard sand, rock		140	160	15. Well grouted? yes With: <input type="checkbox"/> Neat cement <input type="checkbox"/> Bentonite <input checked="" type="checkbox"/> Concrete Depth: From 14 ft. to 4 ft.		
				16. Nearest source of possible contamination: ft. 200 Direction East Type Sewer Well disinfected upon completion? <input checked="" type="checkbox"/> Yes <input type="checkbox"/> No		
				17. Pump: Manufacturer's name Pumpco Not installed Model number 102S711 HP 3/4 Volts 230 Length of drop pipe 147 ft. capacity 9 g.p.m. Type: <input checked="" type="checkbox"/> Submersible <input type="checkbox"/> Turbine <input type="checkbox"/> Jet <input type="checkbox"/> Reciprocating <input type="checkbox"/> Centrifugal <input type="checkbox"/> Other		
				20. Water well contractor's certification: This well was drilled under my jurisdiction and this report is true to the best of my knowledge and belief.		
18. Elevation:		19. Remarks:		High Plains Drilling & Supply, Inc. 136B Business name License No. 402 Nth 3rd Garden City, Ks. 67846 Address Signed Arthur K. Kuhlmann Date 1/15/77 Arthur K. Kuhlmann		

Forward the white, blue and pink copies to the Department of Health and Environment

Form WWC-5