


WATER WELL PLUGGING RECORD Form WWC-5P KSA 82a-1212 ID NO.

1 LOCATION OF WATER WELL: Fraction SW 1/4 1/4 1/4 1/4 Section Number 20 Township Number T 21 S Range Number 36 E W
 County: SW 1/4 1/4 1/4 1/4

Street/Rural Address of Well Location; if unknown, distance & direction from nearest town or intersection: If at owner's address, check here FROM LAKIN 2.2 MI NORTH
 2 MI WEST
 3.4 MI SOUTH

Global Positioning Systems (GPS) information:
 Latitude: 38.2097683 (in decimal degrees)
 Longitude: 101.3033961 (in decimal degrees)
 Elevation: _____
 Datum: WGS84, NAD83, NAD27
 Collection Method: _____
 GPS unit (Make/Model: POSIT)
 Digital Map/Photo, Topographic Map, Land Survey
 Est. Accuracy: <3 m, 3-5 m, 5-15 m, >15 m

2 WATER WELL OWNER: MIKE PUCKETT
 RR#, St. Address, Box #: 1002 W KINGMAN AVE
 City, State ZIP Code: LAKIN KS 67860

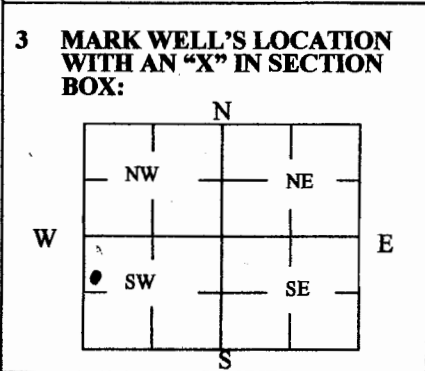

4 DEPTH OF WELL 35 ft.
 WELL'S STATIC WATER LEVEL DRY ft
 WELL WAS USED AS:
 Domestic Public Water Supply Dewatering
 Irrigation Oil Field Water Supply Monitoring
 Feedlot Domestic (Lawn & Garden) Injection Well
 Industrial Air Conditioning Other STOCK

Was a chemical/bacteriological sample submitted to Department? Yes No

5 TYPE OF BLANK CASING USED:

Steel RMP (SR) Wrought Fiberglass Other (Specify below) _____
 PVC ABS Asbestos-Cement Concrete Tile _____

Blank casing diameter 5 in. Was casing pulled? Yes No If yes, how much _____
 Casing height above or below land surface 48" in.

6 GROUT PLUG MATERIAL: Neat cement Cement grout Bentonite Other _____

Grout Plug Intervals: From _____ ft. to _____ ft., From _____ ft. to _____ ft., From _____ to _____ ft.

What is the nearest source of possible contamination:
 Septic tank Seepage pit Fuel Storage Other (specify below) NONE OBSERVED
 Sewer lines Pit privy Fertilizer storage
 Watertight sewer lines Sewage lagoon Insecticide storage
 Lateral lines Feedyard Abandoned water well Direction from well? _____
 Cess pool Livestock pens Oil well/Gas well How many feet? _____

| FROM | TO | PLUGGING MATERIALS | FROM | TO | PLUGGING MATERIALS |
|------|----|---------------------|------|----|--------------------|
| 0 | 4 | TOP SOIL | | | |
| 4 | 14 | BENTONITE HOLEPLUGS | | | |
| 14 | 35 | SAND | | | |
| | | | | | |
| | | | | | |

7 CONTRACTOR'S OR LANDOWNER'S CERTIFICATION: This water well was plugged under my jurisdiction and was completed on (mo/day/year) 8-23-14 and this record is true to the best of my knowledge and belief. Kansas Water Well Contractor's License No. 857. This Water Well Record was completed on (mo/day/year) 9-15-14 under the business name of OASIS CONSTRUCTION LLC by (signature) [Signature]

INSTRUCTIONS: Use typewriter or ballpoint pen. Please press firmly and print clearly. Please fill in blanks, underline or circle the correct answers. Send top three copies to Kansas Department of Health and Environment, Bureau of Water, Geology Section, 1000 SW Jackson St., Ste. 420, Topeka, Kansas 66612-1367. Telephone: 785/296-5524. Send one to Water Well Owner and retain one for your records. Visit us at <http://www.kdheks.gov/waterwell/index.html>.

Check one: White Copy Blue Copy Pink Copy

County: Kearny Fraction SE SW NW SW Sec. 20 T 21 S R 36 E (W)

CORRECTION(S) TO WATER WELL COMPLETION RECORD (WWC-5)
(to rectify lacking or incorrect information)

Owner: Mike Puckett

Location was listed as:

Location changed to:

Section-Township-Range: 20-21S-36

20-21S-36 W

Fraction (1/4 1/4 1/4): SW

SE SW NW SW

Other changes: Initial statements: From Lakin 22 mi North 2 mi West
3/4 mi South.

Changed to: From Lakin: 19 mi. N., 2 mi. W., 3/4 mi S.

Comments: _____

Verification method: Latitude & longitude, KGS' "LEO" conversion tool,
and mapping tool & aerial photos on KGS website.

initials: DR date: 12/1/2014

Submitted by: Kansas Geological Survey, Data Resources Library, 1930 Constant Ave., Lawrence, KS 66047-3726
to: Kansas Dept of Health & Environment, Bureau of Water, 1000 SW Jackson, Suite 420, Topeka, KS 66612-1367.